

323 Bor D  
324

922 4312

WILKINSON  
K29  
7-29-82  
Ely #163

MISSISSIPPI  
BOARD OF WATER COMMISSIONERS  
416 North State Street  
Jackson, Mississippi 39201  
WATER WELL DRILLERS LOG

CODED

July 29 19 82 Layne-Central Company Wilkinson  
date well completed firm name county well located

LANDOWNER: Old River Water  
Association, c/o Fouche' &  
Associates, 5150 Keele St.  
Jackson, Mississippi 39206  
(mailing address)

description of formations encountered	from	to
clay	0	35
sand & gravel	35	95
clay	95	193
lime rock	193	198
hard clay	198	218
sandy clay	218	249
sand & clay streaks	249	276
sand	276	313
sand and clay	313	444
sand and clay streaks	444	506
sand	506	541
clay	541	557

WELL LOCATION:  
sec. 52 T 2N N 3W?  
S W R 4W E  
\_\_\_\_\_ miles \_\_\_\_\_ of \_\_\_\_\_  
(distance) (direction) (nearest town)

WELL PURPOSE: Water Association  
(home, irrigation, municipal, industrial)

WELL COMPLETION DATA:

- (1) diameter (inches) 10"
- (2) total depth (feet) 544'
- (3) static water level (feet) 319' below top of ground.
- (4) casing Steel 483'  
(material) (depth)  
6" If telescope see back.  
(size)
- (5) screen 41'-1", 402' 502'  
(length) (depth to top)  
6", Stainless Steel  
(size) (material)
- (6) pump 30 150  
(HP) (yield gpm)  
Electric  
(type power)
- (7) electric log yes  
(yes or no)  
~~MS Geo. Survey~~ Layne  
(organization running log)  
Stainless
- (8) how well bottom plugged  
Steel Plate

Elevation: 365'

CODED

DEPT. OF NATURAL RESOURCES  
BUREAU OF LAND & WATER RESOURCES

AUG 17 1982  
RECEIVED

DRILLERS REMARKS:



(R)

If well telescopes please  
sketch and show depths.

---

GROUND LEVEL

---

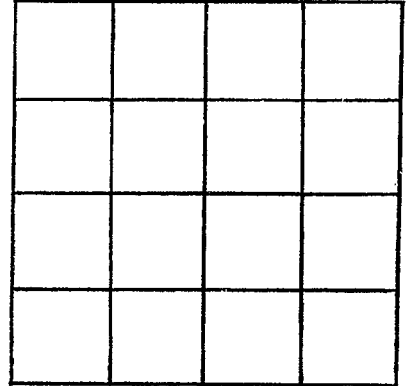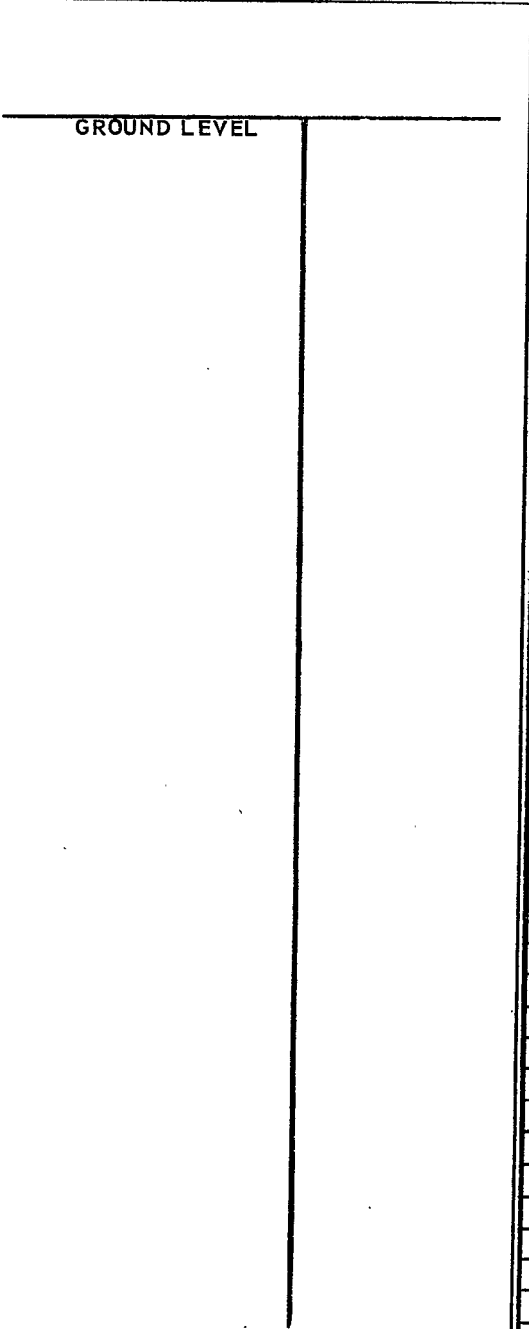

SECTION \_\_\_\_\_

Please indicate well location X.

ADDITIONAL INFORMATION

---

---

If more than one screen,  
show locations of each on sketch.