

WILKINSON
K 30
10/6/82

MISSISSIPPI DEPARTMENT OF NATURAL RESOURCES
Bureau of Land and Water Resources
Southport Mall
P.O. Box 10631
Jackson, Mississippi 39209
WATER WELL DRILLERS LOG

10-6-82 date well completed
Rayburn Drill & Const. Co. firm name
Wilkinson county well located

LANDOWNER:
Rayburn Drill Co.
Natchez MS 39130
(mailing address)

description of formations encountered	from	to
	gumbo	0
sand	30	150

WELL LOCATION:
sec. 5 T 2 N R 5 E
2 S 1 W
(distance) miles (direction) of (nearest town)

500' S + 330' E

WELL PURPOSE:
(home, irrigation, municipal, industrial)

of NW/Cor of

WELL COMPLETION DATA:

- (1) diameter (inches) 3"
- (2) total depth (feet) 150'
- (3) static water level (feet) 30' below top of ground
- (4) casing (material) 130' (depth) 3" (size) if telescope see back.
- (5) screen 30' 130' (length) (depth to top) 3" (size) 24" (material)
- (6) pump (HP) 52 GPM (yield gpm)
- (type power)
- (7) electric log (yes or no)
- (organization running log)

SW NW Sec. 5
Bounded 5-5

CODED

DEPT. OF NATURAL RESOURCES
BUREAU OF LAND & WATER RESOURCES


OCT 14 1982

RECEIVED

(8) how well bottom plugged used plug
DRILLERS REMARKS:

If well telescopes please
sketch and show depths.

GROUND LEVEL

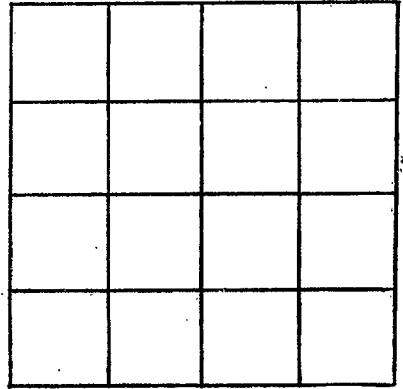

SECTION _____

Please indicate well location X.

ADDITIONAL INFORMATION

If more than one screen,
show locations of each on sketch.