

MISSISSIPPI DEPARTMENT OF NATURAL RESOURCES

Bureau of Land and Water Resources

Southport Mall

P.O. Box 10631

Jackson, Mississippi 39209

WATER WELL DRILLERS LOG

K 32
 Wilkinson
 9-27-83

CODED

9-27-83 date well completed 19 D.S. Harris Well Co. firm name Wilkerson county well located

LANDOWNER: Leak #1
 Drilled for Energy
 Drilling Co.
 (mailing address)

| description of formations encountered | from | to |
|---------------------------------------|------|----|
| Shale | 0 | 16 |
| Sand | 16 | 85 |

WELL LOCATION:
 sec. 24 T 2 N R 4 E
 8 miles N-W of Fort Allen
 (distance) (direction) (nearest town)

Water Supply for Oil Co.

WELL PURPOSE: Ind.
 (home, irrigation, municipal, industrial)

WELL COMPLETION DATA:

(1) diameter (inches) 5

(2) total depth (feet) 85'

(3) static water level (feet) 15 below above top of ground.

(4) casing Plastic, 75 (material) (depth)
 3" (size) if telescope see back.

(5) screen 12 (length) 75 (depth to top)
 3 (size) Plastic (material)

(6) pump NONE (HP) (yield gpm)
 air compressor (type power)

(7) electric log NO (yes or no)

(organization running log)

(8) how well bottom plugged 3" Plug


4710'S & 1644' E of NW/Cor
 NW SE SEC 24-21-46

MISSISSIPPI DEPARTMENT OF NATURAL RESOURCES
 BUREAU OF LAND AND WATER RESOURCES
 OCT 14 1983
 RECEIVED

DRILLERS REMARKS: Drilling Co. responsible for plugging well

If well telescopes please sketch and show depths.

GROUND LEVEL

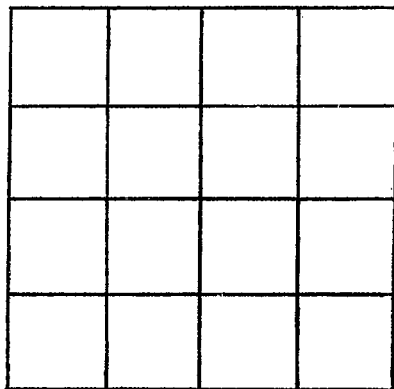

SECTION _____

Please indicate well location X.

ADDITIONAL INFORMATION

If more than one screen,
show locations of each on sketch.