

MISSISSIPPI DEPARTMENT OF NATURAL RESOURCES

Bureau of Land and Water Resources

Southport Mall

P.O. Box 10631

Jackson, Mississippi 39209

WATER WELL DRILLERS LOG

RECEIVED

K 33
Wilkinson
9-17-83

9-17-83 19 D S Harris Well Service with Verson
 date well completed firm name county well located

LANDOWNER	description of formations encountered	from	to
<u>Strickler</u>			
<u>Drilled for Energy</u>	<u>Gumbo</u>	<u>0</u>	<u>82</u>
<u>Drilling CO</u>	<u>COARSE SAND</u>	<u>82</u>	<u>95</u>
(mailing address)			
WELL LOCATION:			
sec. <u>11</u> T. <u>2</u> N. R. <u>5</u> E. S. <u>8</u> W.			
<u>7</u> miles <u>N</u> of <u>Lake Marc</u>			
(distance) (direction) (nearest town)			
WELL PURPOSE: <u>Industrial</u>			
(home, irrigation, municipal, industrial)			
WELL COMPLETION DATA:			
(1) diameter (inches) <u>5</u>	<u># Strickler</u>		
(2) total depth (feet) <u>95</u>	<u>330' S + SIDE of NW/4 SW</u>		
(3) static water level (feet) <u>12</u> below top of ground.	<u>NE NW SEC 11-2N-5W</u>		
(4) casing <u>Plastic, 95</u> (material) (depth)			
(size) If telescope see back.			
(5) screen <u>10</u> (length) <u>85</u> (depth to top)			
<u>3"</u> (size) <u>Plastic</u> (material)			
(6) pump <u>air compressor</u> (HP) (yield gpm)			
(type power)			
(7) electric log <u>NO</u> (yes or no)			
(organization running log)			
(8) how well bottom plugged <u>3" cap</u>			
DRILLERS REMARKS: <u>This well is for a drilling CO & they are responsible for the plugging of well</u>			


DEPT. OF NATURAL RESOURCES
 BUREAU OF LAND & WATER RESOURCES

OCT 10 1983

RECEIVED

If well telescopes please sketch and show depths.

GROUND LEVEL

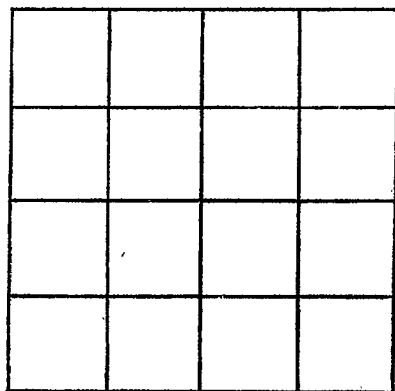

SECTION _____

Please indicate well location X.

ADDITIONAL INFORMATION

If more than one screen, show locations of each on sketch.