

MISSISSIPPI DEPARTMENT OF NATURAL RESOURCES
 Bureau of Land and Water Resources
 Southport Mall
 P.O. Box 10631
 Jackson, Mississippi 39209
WATER WELL DRILLERS LOG

CODED

K34
 Wilkinson
 11-11-83

11-11 1983 Rayborn Drill & Condr Co. Wilkinson
 date well completed firm name county well located

LANDOWNER:	description of formations encountered	from	to
David New Drilling Natchez, MS. (drilling address)	gumbo	0	40
WELL LOCATION: sec. 16 T 20 S R 5 E W	sand	40	110
_____ miles _____ of _____ (distance) (direction) (nearest town)			
WELL PURPOSE: (home, irrigation, municipal, industrial)			
WELL COMPLETION DATA:			
(1) diameter (inches) 3"			
(2) total depth (feet) 110'			
(3) static water level (feet) 10' below top of ground.	Purchase 16-2 #1		
(4) casing PVC, 100' (material), (depth), 3" (size) if telescope see back.			
(5) screen: 10' (length), 100' (depth to top)			
3" (size), "PVC" (material)			
(6) pump - 53 Gpm (HP) (yield gpm)			
_____ (type power)			
(7) electric log no (yes or no)			
_____ (organization running log)			
(8) how well bottom plugged wood plug			
DRILLERS REMARKS:			


DEPT. OF NATURAL RESOURCES
 BUREAU OF LAND & WATER RESOURCES

NOV 14 1983

RECEIVED

If well telescopes please sketch and show depths.

GROUND LEVEL

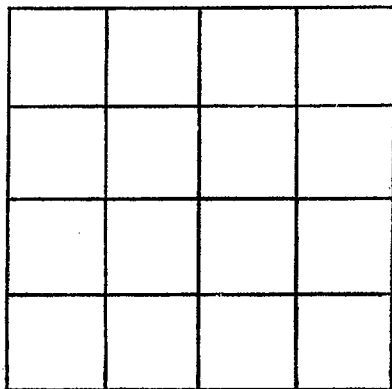

SECTION _____

Please indicate well location X.

ADDITIONAL INFORMATION

If more than one screen,
show locations of each on sketch.