

MISSISSIPPI DEPARTMENT OF NATURAL RESOURCES

Bureau of Land and Water Resources

Southport Mall

P.O. Box 10631

Jackson, Mississippi 39209

WATER WELL DRILLERS LOG

Griner Drilling Service Inc

Wilkinson

CODED

K35
 Wilkinson Co.
 11-4-83

11-4-83 date well completed

Griner Drilling Service Inc firm name

Wilkinson county well located


LANDOWNER:	description of formations encountered	from	to
Helmerich and Payne P.O. Box 6173 Pearl, Ms. 39208 (mailing address)	SAND	0	126
WELL LOCATION: 8406'S + 1200'W No. 1 of 2 T 20N R 5 E NE/4 plantation of Fort Adams (distance) 2.58 (direction) (nearest town)	SW1/4, SE1/4, NE1/4		
WELL PURPOSE: oil field supply (home, irrigation, municipal, industrial)			
WELL COMPLETION DATA:			
(1) diameter (inches) 4"			
(2) total depth (feet) 126'			
(3) static water level (feet) 20' below top of ground.			
(4) casing Steel 126' (material) (depth) 4" (size) If telescope see back.			
(5) screen 42' 84' (length) (depth to top) 4" perforated (size) (material)			
(6) pump AC (HP) 80 (yield gpm) (type power)			
(7) electric log (yes or no) (organization running log)			
(8) how well bottom plugged orange peel			
DRILLERS REMARKS:			

DEPT. OF NATURAL RESOURCES
 BUREAU OF LAND & WATER RESOURCES

NOV 29 1983
 RECEIVED

If well telescopes please sketch and show depths.

GROUND LEVEL

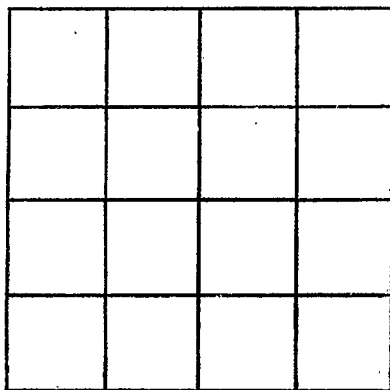

SECTION _____

Please indicate well location X.

ADDITIONAL INFORMATION

If more than one screen,
show locations of each on sketch.