

MISSISSIPPI DEPARTMENT OF NATURAL RESOURCES

Bureau of Land and Water Resources

Southport Mall

P.O. Box 10631

Jackson, Mississippi 39209

WATER WELL DRILLERS LOG

CODED

WILKINSON  
K 36  
11/183

11 1 19 83 B & P Drilling Inc. Wilkinson  
date well completed firm name county well located

LANDOWNER:	description of formations encountered	from	to
Wick Leven Plantation Woodville Miss. Rt 2 Box 784 (mailing address)	Top Soil + Grubs Fine Sand + Course Course	0 15 95	15 96 100
WELL LOCATION: sec. <u>L T 2 N</u> R. <u>5 E</u> <u>8</u> miles <u>S</u> of <u>Fort Adams</u> (distance) (direction) (nearest town)			
WELL PURPOSE: <u>Domestic</u> (home, irrigation, municipal, industrial)			
WELL COMPLETION DATA:			
(1) diameter (inches) <u>10"</u>			
(2) total depth (feet) <u>100'</u>			
(3) static water level (feet) <u>20'</u> below above top of ground.			
(4) casing <u>Plastic</u> , <u>70'</u> (material) (depth)			
(size) if telescope see back.			
(5) screen <u>30'</u> , <u>70'</u> (length) (depth to top)			
<u>10"</u> , <u>Plastic</u> (size) (material)			
(6) pump <u>15</u> <u>1200</u> (HP) (yield gpm)			
<u>Electric</u> (type power)			
(7) electric log _____ (yes or no)			
_____ (organization running log)			
(8) how well bottom plugged <u>Cap</u>			
DRILLERS REMARKS:			

CODED

DEPT. OF NATURAL RESOURCES  
BUREAU OF LAND & WATER RESOURCES


DEC - 1 1983

RECEIVED

Ⓐ

If well telescopes please sketch and show depths.

GROUND LEVEL

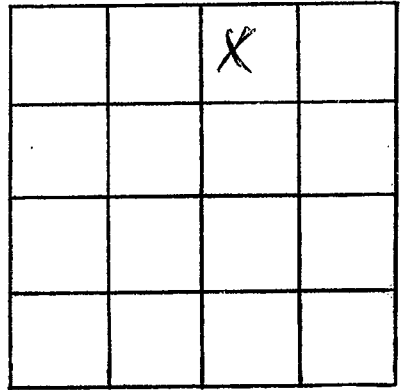

SECTION 1

Please indicate well location X.

ADDITIONAL INFORMATION

If more than one screen,  
show locations of each on sketch.