

MISSISSIPPI DEPARTMENT OF NATURAL RESOURCES

Bureau of Land and Water Resources

Southport Mall

P.O. Box 10631

Jackson, Mississippi 39209

WATER WELL DRILLERS LOG

CODED

WILKINSON
K37
8/4/83

8 4 1983 B & F Drilling Inc Wilkinson
date well completed firm name county well located

LANDOWNER: W. H. Pritchard
#1
American Well Drilling
Lafayette La.
(mailing address)

description of formations encountered	from	to
	Top soil	0
Gumbo soil	10	30
Sand	30	130

WELL LOCATION:
sec. 12 T 2 N R 5 E
6 miles SW of Fort Adams
(distance) (direction) (nearest town)

WELL PURPOSE: Supply Well
(home, irrigation, municipal, industrial)

CODED

WELL COMPLETION DATA:

- (1) diameter (inches) 3"
- (2) total depth (feet) 130'
- (3) static water level (feet) 8' below top of ground.
- (4) casing Plastic, 120' (material) (depth)
- if telescope see back.
(size)
- (5) screen 10' 120' (length) (depth to top)
3" Plastic (size) (material)
- (6) pump (HP) (yield gpm)
Air (type power)
- (7) electric log (yes or no)
(organization running log)
- (8) how well bottom plugged Cap

DRILLERS REMARKS: Left for Use Again


DEPT. OF NATURAL RESOURCES
BUREAU OF LAND & WATER RESOURCES

DEC - 1 1983

RECEIVED

If well telescopes please sketch and show depths.

GROUND LEVEL

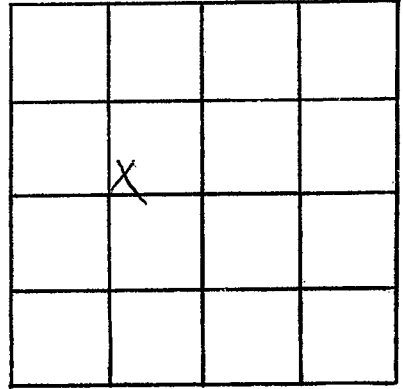

SECTION _____

Please indicate well location X.

ADDITIONAL INFORMATION

If more than one screen,
show locations of each on sketch.