

MISSISSIPPI DEPARTMENT OF NATURAL RESOURCES

Bureau of Land and Water Resources

Southport Mall

P.O. Box 10631

Jackson, Mississippi 39209

CODED

WATER WELL DRILLERS LOG

K38
Wilkinson Co
4-2-84

4-2-84 *Griner Drilling Service, Inc.* *WILKINSON*
date well completed firm name county well located

LANDOWNER:
Transcontinental Drilling
1700 Capital Towers
Jackson, Ms. 39201
(mailing address)

description of formations encountered	from	to
SAND	0	105
Chalk streaks	105	189
chalk, rock	189	210
SAND	210	231
chalk, rock	231	274
streaked chalk	274	336
SAND		
chalk	336	378
SAND	378	441
CHALK	441	504
SAND	504	567
streaked	567	588
SAND	588	651
SAND	651	672

WELL LOCATION: *1125'N 1873'W*
sec. *51* T. *2* N R. *4* SE 1/4 cor
NP Alice Chambers Pond Field
(distance) miles (direction) of (nearest town)

WELL PURPOSE: *oil field supply*
(home, irrigation, municipal, industrial)

WELL COMPLETION DATA:

(1) diameter (inches) 3"

(2) total depth (feet) 672'

(3) static water level (feet) 320' (below/above top of ground)

(4) casing steel 651'
(material) (depth)

3"
(size) if telescope see back.

(5) screen 42' 609'
(length) (depth to top)

3" perforated
(size) (material)

(6) pump — 45
(HP) (yield gpm)

AC
(type power)

(7) electric log —
(yes or no)

(organization running log)

(8) how well bottom plugged ORANGE PEEL

DRILLERS REMARKS:


DEPT. OF NATURAL RESOURCES
BUREAU OF LAND & WATER RESOURCES

APR 12 1984

RECEIVED

If well telescopes please sketch and show depths.

GROUND LEVEL

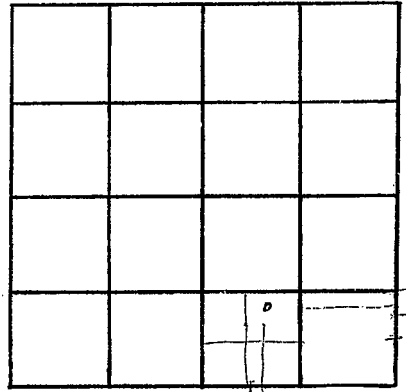

SECTION _____

Please indicate well location X.

ADDITIONAL INFORMATION

If more than one screen,
show locations of each on sketch.