

MISSISSIPPI DEPARTMENT OF NATURAL RESOURCES

Bureau of Land and Water Resources

Southport Mall

P.O. Box 10631

Jackson, Mississippi 39209

CODED

WATER WELL DRILLERS LOG

Griner Drilling Service, INC.

Wilkinson

WILKINSON  
1540  
8/9/84

8-9-84  
date well completed

Griner Drilling Service, INC.  
firm name

Wilkinson  
county well located

LANDOWNER:

Transcontinental Drilling  
1700 Capital Towers  
Jackson, MS. 39201

(mailing address)

description of formations encountered

from

to

clay, sand, mostly clay  
0 445  
sand, pea gravel 445 525

WELL LOCATION: 1920'S & 121'E

Sec. 51 T. 2 N. R. 4 NW  
Lester Bryan Woodville  
miles (direction) of (nearest town)

WELL PURPOSE: oilfield supply  
(home, irrigation, municipal, industrial)

WELL COMPLETION DATA:

- (1) diameter (inches) 3"
- (2) total depth (feet) 525'
- (3) static water level (feet) 100' below top of ground.
- (4) casing steel, 525' (material) (depth)
- 3" (size) if telescope see back.
- (5) screen 42' 483' (length) (depth to top)
- 3" perforated (size) (material)
- (6) pump — 70 (HP) (yield gpm)
- AC (type power)
- (7) electric log — (yes or no)
- (organization running log)

CODED

- (8) how well bottom plugged orange peel

DRILLERS REMARKS:


DEPT. OF NATURAL RESOURCES  
BUREAU OF LAND & WATER RESOURCES

SEP - 4 1984

RECEIVED

If well telescopes please sketch and show depths.

GROUND LEVEL

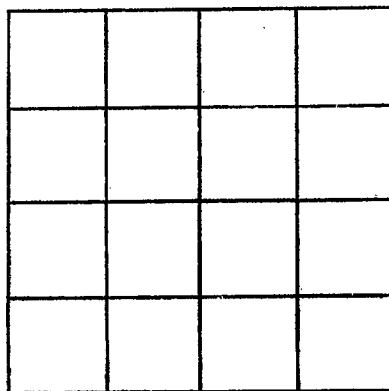

SECTION \_\_\_\_\_

Please indicate well location X.

ADDITIONAL INFORMATION

If more than one screen, show locations of each on sketch.