

MISSISSIPPI DEPARTMENT OF NATURAL RESOURCES

Bureau of Land and Water Resources

Southport Mall

P.O. Box 10631

Jackson, Mississippi 39209

WATER WELL DRILLERS LOG

CODED

Wilkinson
K 42

Aug 22 19 84 St. Bernard Wilkinson
date well completed firm name county well located

LANDOWNER: Energy Drilling
Co. 413 Liberty Rd.
Natchez Miss
(mailing address)

description of formations encountered	from	to
<u>Top Soil</u>	<u>0</u>	<u>15</u>
<u>Fine Sand</u>	<u>15</u>	<u>100</u>
<u>Course Sand</u>	<u>100</u>	<u>120</u>

WELL LOCATION:
sec. 24 T 2 N R 4 E
12 miles W of Wardville
(distance) (direction) (nearest town)

WELL PURPOSE: Supply
(home, irrigation, municipal, industrial)

- WELL COMPLETION DATA:
- (1) diameter (inches) 3"
 - (2) total depth (feet) 120'
 - (3) static water level (feet) 20' below top of ground.
 - (4) casing Plastic, 110'
(material) (depth)
3" if telescope see back.
(size)
 - (5) screen 10', 110'
(length) (depth to top)
3", Plastic
(size) (material)
 - (6) pump _____
(HP) (yield gpm)
Air
(type power)
 - (7) electric log No
(yes or no)
 - (organization running log)

(8) how well bottom plugged Plugged

DRILLERS REMARKS:


CODED

DEPT. OF NATURAL RESOURCES
BUREAU OF LAND & WATER RESOURCES

SEP 14 1984
RECEIVED

If well telescopes please sketch and show depths.

GROUND LEVEL

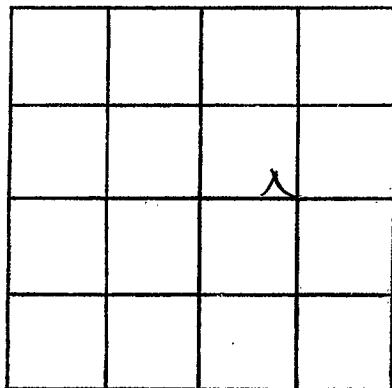

SECTION 24

Please indicate well location X.

ADDITIONAL INFORMATION

If more than one screen, show locations of each on sketch.