

MISSISSIPPI DEPARTMENT OF NATURAL RESOURCES

Bureau of Land and Water Resources

Southport Mall

P.O. Box 10631

Jackson, Mississippi 39209

WATER WELL DRILLERS LOG

CODED

Wilkinson
K44
9/18/84

9/18 1984 Rayborn Drilling Wilkinson
date well completed firm name county well located

LANDOWNER:	description of formations encountered	from	to
Trace Drilling Fletcher, m3 (mailing address)	Top Soil	0	5
	Clay	6	20
	Fine sand	21	110
	Coar. sand	111	130
WELL LOCATION: sec 6 T 2 N R 5 E 6 miles NW of Adam (distance) (direction) (nearest town)			
WELL PURPOSE: <u>WATER</u> (home, irrigation, municipal, industrial)			
WELL COMPLETION DATA:			
(1) diameter (inches) <u>3"</u>			
(2) total depth (feet) <u>130'</u>			
(3) static water level (feet) <u>10'</u> below above top of ground.			
(4) casing <u>blk pipe, 110'</u> (material) (depth) <u>3"</u> if telescope see back. (size)			
(5) screen <u>20', 110'</u> (length) (depth to top) <u>3" Jotted Pipe</u> (size) (material)			
(6) pump <u>50</u> (HP) (yield gpm)			
(type power)			
(7) electric log <u>no</u> (yes or no)			
(organization running log)			
(8) how well bottom plugged <u>wood</u>			

Lease Name:
Stricker 6-1

CODED


RECORDED
JAN 24 1985

DRILLERS REMARKS:

Department of Natural Resources
Bureau of Land & Water Resources

If well telescopes please
sketch and show depths.

GROUND LEVEL

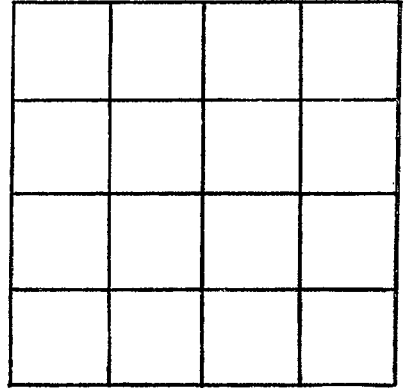

SECTION _____

Please indicate well location X.

ADDITIONAL INFORMATION

If more than one screen,
show locations of each on sketch.