

MISSISSIPPI DEPARTMENT OF NATURAL RESOURCES

Bureau of Land and Water Resources

Southport Mall

P.O. Box 10631

Jackson, Mississippi 39209

WATER WELL DRILLERS LOG



Wilkinson  
K45  
9/12/84

9/12 84 Payton Drilling Wilkinson  
date well completed firm name county well located

LANDOWNER:  
Trace Drilling  
Natchez, MS  
(mailing address)

description of formations encountered	from	to
Top Soil	0	10
Clay	11	50
Sand	51	110


WELL LOCATION:  
sec. 4<sup>N</sup> T. 2<sup>N</sup> R. 4<sup>E</sup>  
2 miles NE of Adam  
(distance) (direction) (nearest town)

WELL PURPOSE: oil field  
(home, irrigation, municipal, industrial)

Lease Name:  
Rosenblatt #6

WELL COMPLETION DATA:


- (1) diameter (inches) 3"
- (2) total depth (feet) 110'
- (3) static water level (feet) \_\_\_\_\_ below/above top of ground.
- (4) casing PVC pipe, 3" (size) if telescope see back, 90' (depth)
- (5) screen 20' (length) 90' (depth to top) 3" PVC slotted pipe (size) (material)
- (6) pump \_\_\_\_\_ (HP) 50 (yield gpm)
- (7) electric log NO (yes or no)
- (organization running log)
- (8) how well bottom plugged wood

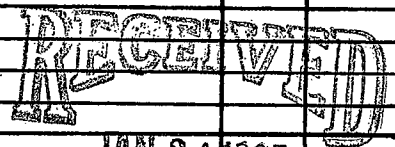

DRILLERS REMARKS:

If well telescopes please  
sketch and show depths.

GROUND LEVEL

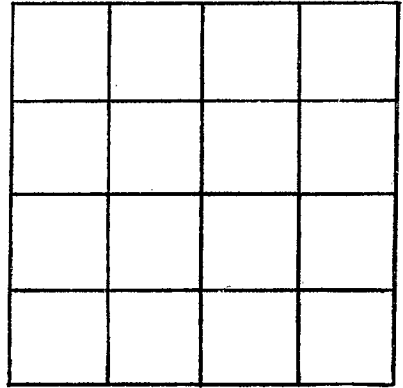

SECTION \_\_\_\_\_

Please indicate well location X.

ADDITIONAL INFORMATION

If more than one screen,  
show locations of each on sketch.