

MISSISSIPPI DEPARTMENT OF NATURAL RESOURCES

Bureau of Land and Water Resources

Southport Mall

P.O. Box 10631

Jackson, Mississippi 39209

WATER WELL DRILLERS LOG

CODED

Wilkinson
K46
9/8/84

9/8 1984 date well completed

Raybon Drilling firm name

Wilkinson county well located

LANDOWNER:

D & D Drilling
Ferriday, LA
(mailing address)

description of formations encountered

Gumbo
Sand

from

to

0 45
40 140

WELL LOCATION:

sec. 5 T. 2 N R. 3 E
14 miles NW of Ferriday
(distance) (direction) (nearest town)

WELL PURPOSE: oil field
(home, irrigation, municipal, industrial)

WELL COMPLETION DATA:

- (1) diameter (inches) 3"
- (2) total depth (feet) 140'
- (3) static water level (feet) 15' below above top of ground.
- (4) casing bk pipe, 120'
(material) (depth)
3" if telescope see back.
(size)
- (5) screen 20', 120'
(length) (depth to top)
3", slotted pipe
(size) (material)
- (6) pump 50
(HP) (yield gpm)

(type power)
- (7) electric log no
(yes or no)

(organization running log)
- (8) how well bottom plugged wood


DRILLERS REMARKS:

RECEIVED
JAN 24 1985

Department of Natural Resources
Bureau of Land & Water Resources

If well telescopes please
sketch and show depths.

GROUND LEVEL

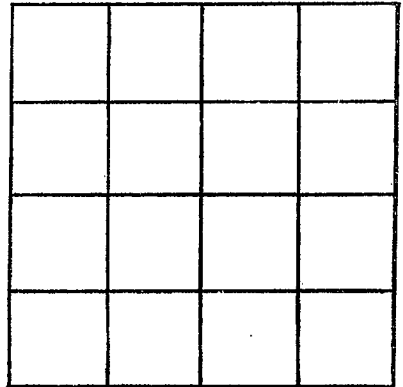

SECTION _____

Please indicate well location X.

ADDITIONAL INFORMATION

If more than one screen,
show locations of each on sketch.