

MISSISSIPPI DEPARTMENT OF NATURAL RESOURCES

Bureau of Land and Water Resources

Southport Mall

P.O. Box 10631

Jackson, Mississippi 39209

WATER WELL DRILLERS LOG

CODED

K47
Wilkinson
5-20-85

5/20 1985 Rayborn Drilling Wilkinson Co.
 date well completed firm name county well located

LANDOWNER: David New Orly

description of formations encountered

from to

P.O. Box 1487

Top Soil

0 3

Natchez Ms 39120

Chalk

3 80

(mailing address)

WELL LOCATION:

Streaked Sand

80 105

sec. 38 T 2 N R 4 E
 S W
 2 miles N of Ft. Adams
 (distance) (direction) (nearest town)

Chalk

105 120

WELL PURPOSE: oil field
 (home, irrigation, municipal, industrial)

Sand

120 130

WELL COMPLETION DATA:

FR SECOR SEC 29, op W

- (1) diameter (inches) 3"
- (2) total depth (feet) 130'
- (3) static water level (feet) 10' (below) above top of ground.

aby sec/L 39'; 4th SEC RA

1643' to 100' in SEC 24-1N-4W

- (4) casing blk pipe, 110' (material) (depth), 3" (size) if telescope see back.
- (5) screen 20' (length), 110' (depth to top), 3" (size), slotted pipe (material)

Lease Name:

Rosenblatt #1

- (6) pump (HP) 50 (yield gpm)

(type power)

- (7) electric log no (yes or no)

(organization running log)

- (8) how well bottom plugged wood

RECEIVED


OCT - 8 1985

DRILLERS REMARKS:

Department of Natural Resources
 Bureau of Land & Water Resources

If well telescopes please
sketch and show depths.

GROUND LEVEL

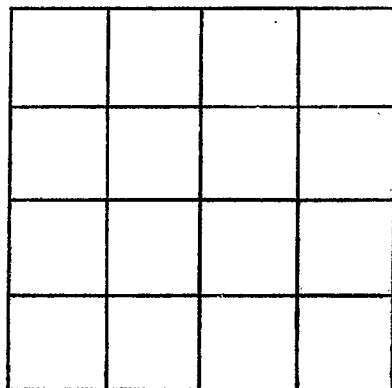

SECTION _____

Please indicate well location X.

ADDITIONAL INFORMATION

If more than one screen,
show locations of each on sketch.