

MISSISSIPPI DEPARTMENT OF NATURAL RESOURCES

Bureau of Land and Water Resources

Southport Mall

P.O. Box 10631

Jackson, Mississippi 39209

WATER WELL DRILLERS LOG

CODED

Wilkinson  
R048


1/24 1986 date well completed      Rayborn Drig Co firm name      Wilkinson county well located

LANDOWNER: <u>David New</u>	description of formations encountered	from	to
<u>Drig Co, PO Box 1487,</u> <u>Natchez Ms 39120</u> (mailing address)			
	<u>Top Soil</u>	<u>0</u>	<u>15</u>
	<u>Gravel</u>	<u>15</u>	<u>50</u>
WELL LOCATION:	<u>Chalk</u>	<u>50</u>	<u>190</u>
sec. <u>41</u> T. <u>2N</u> S. R. <u>4E</u> W.	<u>Sand</u>	<u>190</u>	<u>260</u>
<u>2</u> miles <u>NE</u> of <u>Ft. Adams</u> (distance) (direction) (nearest town)	<u>Chalk</u>	<u>260</u>	<u>285</u>
WELL PURPOSE: <u>oilfield</u> (home, irrigation, municipal, industrial)	<u>Sand</u>	<u>285</u>	<u>315</u>

- WELL COMPLETION DATA:
- (1) diameter (inches) 3"
  - (2) total depth (feet) 315'
  - (3) static water level (feet) 130' below above top of ground.
  - (4) casing PVC Pipe, 305'  
(material) (depth)  
3"  
(size) if telescope see back.
  - (5) screen 10', 305'  
(length) (depth to top)  
3", PVC Slotted Pipe  
(size) (material)
  - (6) pump —, 50  
(HP) (yield gpm)  
—  
(type power)
  - (7) electric log no  
(yes or no)  
—  
(organization running log)
  - (8) how well bottom plugged wood

in SE/4 of Sec 27, go  
W/ly a la sec 12 938' th S'ly  
@ RA 2003' to loc. in  
Sec 41-2N-4W

Lease Name:  
Rosenblatt #2

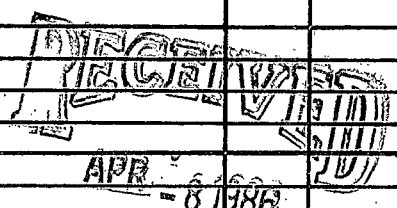


DRILLERS REMARKS: \_\_\_\_\_

Department of Natural Resources  
Bureau of Land & Water

If well telescopes please  
sketch and show depths.

GROUND LEVEL

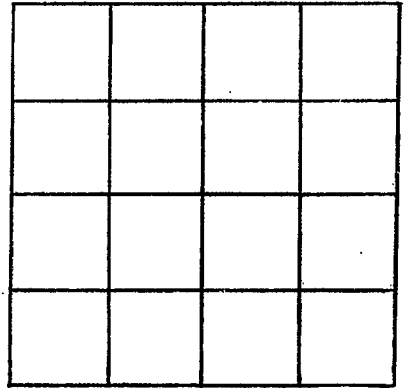

SECTION \_\_\_\_\_

Please indicate well location X.

ADDITIONAL INFORMATION

If more than one screen,  
show locations of each on sketch.