

MISSISSIPPI DEPARTMENT OF NATURAL RESOURCES
 Bureau of Land and Water Resources
 Southport Mall
 P.O. Box 10631
 Jackson, Mississippi 39209
WATER WELL DRILLERS LOG

CODED

WILKINSON
K 49

4/14 1986 Rayborn Drilling Co. Wilkinson
 date well completed firm name county well located

| LANDOWNER: <u>David New Oil Co.</u> | description of formations encountered | from | to |
|--|---------------------------------------|-----------|------------|
| <u>P.O. Box 1487</u> | <u>Gumbo</u> | <u>0</u> | <u>90</u> |
| <u>Natchez Ms 39120</u> (mailing address) | <u>Sand</u> | <u>91</u> | <u>130</u> |

CODED


WELL LOCATION:
 sec. 41 T. 2 N. R. 4 E. W. W
2 miles N of Et. Adams
 (distance) (direction) (nearest town)

3 ROSENBLATT
EP# SE / COR SEC 27, 90W / LY ALG
SEC 12 1160', THS' LY @ RA 2675'

WELL PURPOSE: oil field
 (home, irrigation, municipal, industrial)

- WELL COMPLETION DATA:**
- (1) diameter (inches) 3"
 - (2) total depth (feet) 130'
 - (3) static water level (feet) 4' below above top of ground.
 - (4) casing PVC Sch 40, 120',
 (material) (depth)
3" if telescope see back.
 (size)
 - (5) screen 10', 120'
 (length) (depth to top)
3", PVC Sch 40 slotted pipe
 (size) (material)
 - (6) pump - 50
 (HP) (yield gpm)
electric
 (type power)
 - (7) electric log no
 (yes or no)
 (organization running log)
 - (8) how well bottom plugged wood

Rosenblatt Lease

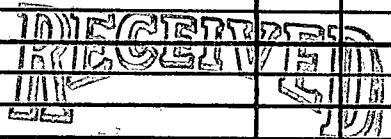


SEP 19 1986

Department of Natural Resources
 Bureau of Land & Water Resources

DRILLERS REMARKS:

If well telescopes please
sketch and show depths.

GROUND LEVEL

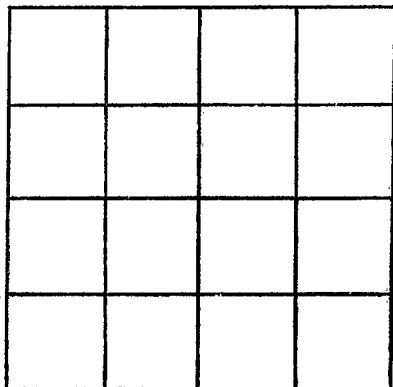

SECTION _____

Please indicate well location X.

ADDITIONAL INFORMATION

If more than one screen,
show locations of each on sketch.