

MISSISSIPPI DEPARTMENT OF NATURAL RESOURCES

Bureau of Land and Water Resources

Southport Mall

P.O. Box 10631

Jackson, Mississippi 39209

WATER WELL DRILLERS LOG

CODED

WILKINSON
~~B-47~~
 K51

12-6-85 date well completed
 Griner Drilling Service, Inc. firm name
 Wilkinson county well located

LANDOWNER:	description of formations encountered	from	to
See Land Drilling 900 Duane St. Houma, La. 70360 (mailing address)	GRAVEL	0	105
	CLAY	105	252
WELL LOCATION: 1985 S 4 710' W sec. 51 T. 2 N R. 4 E of NE 1/4	streaked	252	357
No. 1 Millbrook Field D'Aquila (distance) (direction) (nearest town)	SAND	357	441
WELL PURPOSE: oil field supply (home, irrigation, municipal, industrial)	streaked	441	567
WELL COMPLETION DATA:	SAND	567	651
(1) diameter (inches) 3"			
(2) total depth (feet) 651'			
(3) static water level (feet) 206' below above top of ground.			
(4) casing: steel, 651' (material) (depth) 0.3" (size) if telescope see back.			
(5) screen 63' (length), 588' (depth to top) 3" (size), perforated (material)			
(6) pump - 60 (HP) (yield gpm) AC (type power)			
(7) electric log (yes or no) <input checked="" type="checkbox"/> (organization running log)			
(8) how well bottom plugged orange peel			
DRILLERS REMARKS:			

CODED


RECEIVED

JAN 13 1986

Department of Natural Resources
 Bureau of Land & Water Resources

If well telescopes please
sketch and show depths.

GROUND LEVEL

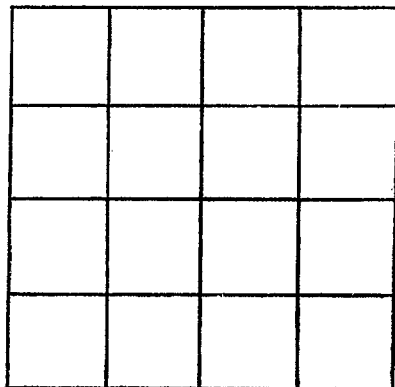

SECTION _____

Please indicate well location X.

ADDITIONAL INFORMATION

If more than one screen,
show locations of each on sketch.