

# CODED

## MISSISSIPPI DEPARTMENT OF NATURAL RESOURCES

Bureau of Land and Water Resources

COUNTY WELL LOCATED	
Wilkinson	
WELL NUMBER	CODED
Rosenblatt	
# <b>K</b> 52	
DATE WELL COMPLETED	
3-7-88	

PERMIT NUMBER
<b>RAYBORN DRILLING, INC.</b>
NAME OF DRILLING FIRM
Rt 5 Box 98
Natchez Ms 39120

P.O. Box 10631  
 Jackson, Mississippi 39209  
 WATER WELL DRILLERS LOG

NAME & MAILING ADDRESS OF LANDOWNER			
W.T. Drilling			
P.O. Box 1487			
Natchez Ms 39120			
WELL LOCATION:	SEC	TOWNSHIP	RANGE
	39	2 <sup>N</sup> <sub>S</sub>	4 <sup>E</sup> <sub>W</sub>
DISTANCE	DIRECTION	NEAREST TOWN	
2 Miles	N	of Ft. Adams	
OTHER LANDMARK			
WELL PURPOSE: Home, Irrigation, Municipal, Industrial, Fish Pond, etc.			
Oilfield			

PUMP DATA				
PUMP TYPE (Circle One):				
Submersible,	Turbine,	Jet	Flowing Well,	
Other (Describe) <u>Air</u>				
POWER TYPE (Circle One):				
<u>Electric</u> ,	Tractor,	Diesel,	Gasoline,	Butane,
Other (Describe)				
Pump Capacity (GPM)	No. of Stages	Setting Depth		
		FT.		
PUMP TEST				
Well yielded <u>50</u> GPM with				
a drawdown of _____ ft.				
after _____ hours of pumping				

WELL DATA		
Well Depth	Casing Diameter (In.)	Casing Length (Ft.)
740'	3"	730'
Type of Casing	Hole Depth	Depth to Static Water Level
Sch 40 PVC	740'	200'
TYPE OF COMPLETION: (Circle One or More):		
Gravel Packed,	Underreamed,	Telescoped,
<u>Natural Development,</u>	Open Hole,	Other
(Describe)		
Top of Lap Pipe or Reduction in Casing		
FEET IF TELESCOPED OR MORE THAN ONE SCREEN: USE BACK PAGE		


LOG DATA	
TYPE OF LOG RUN (Circle One):	
Electric, Gamma Ray, Density, Sonic, Neutron,	<u>No Log Run,</u>
Other (Describe)	
Name of Organization Running Log	

SCREEN DATA		
Diameter - Inches	Length - Feet	Slot Size - Inches
3"	10'	.020
Screen Type	Depth to Bottom - Feet	
Sch 40 Slotted PVC	740'	

GEOLOGIC DATA (Office Use Only)			
Surface Elev.	Geologic Unit	Unit Thickness	Depth to Top
Subs. SWL	Date	Analysis	Aquifer Test


Driller's Remarks	

DESCRIPTION OF FORMATIONS ENCOUNTERED	FROM	TO
Top Soil	0	3
Chalk/Clay	3	690
Sand	690	740

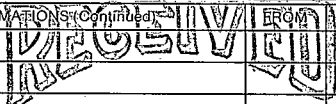FORMATIONS (Continued)	FROM	TO
		
JUL 06 1988		
Department of Natural Resources Bureau of Land & Water Resources		
IF MORE SPACE IS NEEDED, USE BACK		

If well telescopes please  
sketch and show depths.

GROUND LEVEL

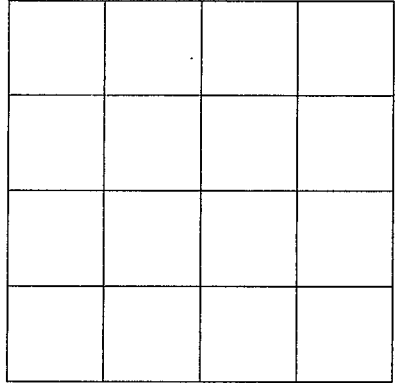

SECTION \_\_\_\_\_

Please indicate well location X.

ADDITIONAL INFORMATION

If more than one screen,  
show location of each on sketch.