

MISSISSIPPI DEPARTMENT OF ENVIRONMENTAL QUALITY

MSGW

Office of Land and Water Resources

P. O. Box 10631
Jackson, MS 39289-0631
WATER WELL DRILLERS LOG

COUNTY WELL LOCATED Wilkinson	
WELL NUMBER # 6	CODED
K-60	
DATE WELL COMPLETED 12/18/00	

PERMIT NUMBER 5315974
NAME OF DRILLING FIRM Morphis Bro. Tract, La 71371

NAME & MAILING ADDRESS OF LANDOWNER Penelore Corp.		
P.O. Box 1076		
Att. Don Detriest		
Columbus, MS 39703		
WELL LOCATION: SEC	TOWNSHIP	RANGE
43	2	4
DISTANCE	DIRECTION	NEAREST TOWN
21 Miles	W	Woodville
OTHER LANDMARK		
WELL PURPOSE: Home, Irrigation, Municipal, Industrial, Fish Pond, etc. De-Watering site		

PUMP DATA		
PUMP TYPE (Circle One): Submersible, <u>Turbine</u> , Jet, Flowing Well, Other (Describe) _____		
POWER TYPE (Circle One): Electric, Tractor, <u>Diesel</u> , Gasoline, Butane, Other (Describe) _____ H/P _____		
Pump Capacity (GPM)	No. of Stages	Setting Depth
		FT.
PUMP TEST		
Well yielded _____ GPM with a drawdown of _____ ft. after _____ hours of pumping		

WELL DATA		
Well Depth 174	Casing Diameter (In.) 16	Casing Length (Ft.) 116
Type of Casing PVC	Hole Depth 174	Depth to Static Water Level
TYPE OF COMPLETION: (Circle One or More): <u>Gravel Packed</u> , Underreamed, Telescoped, Natural Development, Open Hole, Other		

LOG DATA	
TYPE OF LOG RUN (Circle One): Electric, Gamma Ray, Density, Sonic, Neutron, Other (Describe) _____	
Name of Organization Running Log	

WELL GROUTED TO A DEPTH OF _____ FEET
Type Grout (circle one): Cement, Bentonite, or Mix

GEOLOGIC DATA (Office Use Only)			
Surface Elev.	Geologic Unit	Unit Thickness	Depth to Top
Subs. SWL	Date	Analysis	Aquifer Test

SCREEN DATA		
Diameter - Inches 16	Length - Feet 60	Slot Size - Inches 1.032
Screen Type	Depth to Bottom - Feet	

Driller's Remarks


DESCRIPTION OF FORMATIONS ENCOUNTERED	FROM	TO	FORMATIONS (Continued)	FROM	TO
Brown + Gray Clay	0	10	Med Gray Sand	150	160
Gray Clay	10	20	Sand + Gravel	160	174
Silty Gray Clay	20	40			
Sandy Gray Clay	40	60			
Silty Fine Gray Sand w/cb	60	80			
Fine + Med Gray Sand	80	110			
Med + Coarse Sand	110	120			
w/Small Gravel		120			
Coarse Sand + Gravel	120	140			
Blue Clay	140	141			
Sand + Gravel	141	150			

RECEIVED
DEC 31 2002
BY: OLWR

IF MORE SPACE IS NEEDED, USE BACK

If well telescopes please
sketch and show depths.

GROUND LEVEL

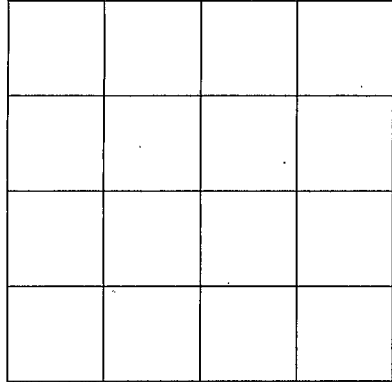

SECTION _____

Please indicate well location X.

ADDITIONAL INFORMATION

If more than one screen,
show location of each on sketch.