

WILKINSON
 K. 2000
 8-6-75

MISSISSIPPI
 BOARD OF WATER COMMISSIONERS
 416 North State Street
 Jackson, Mississippi 39201

WATER WELL DRILLERS LOG

8-6 date well completed 25 Rayborn Drilling & Erectors firm name Wilkinson county well located

LANDOWNER:
 Bill Martin
 Fort Adams, Miss.
 (mailing address)

WELL LOCATION: 14E
 sec. 17 T. 2 N. R. 4 E. Leakey
 1 1/2 miles West of Ruston
 (distance) (direction) (nearest town)

description of formations encountered	from	to
		0
blue clay	2	30
sand	27	31
blue clay	31	32
sand	32	133

WELL PURPOSE: None
 (home, irrigation, municipal, industrial)

WELL COMPLETION DATA:

(1) diameter (inches) 2"

(2) total depth (feet) 133'

(3) static water level (feet) 31' below top of ground.

(4) casing Galv. 126'
 (material) (depth)
2" If telescope see back.
 (size)

(5) screen 5' 126'
 (length) (depth to top)
2" Galv.
 (size) (material)


(6) pump 1 66 GPM
 (HP) (yield gpm)
elec.
 (type power)

(7) electric log no
 (yes or no)

(organization running log)

(8) how well bottom plugged well plug


DRILLERS REMARKS:

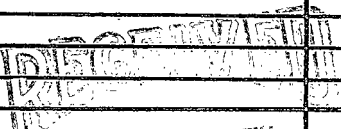

MISS. BD. OF WATER COMMISSIONERS

If well telescopes please sketch and show depths.

GROUND LEVEL

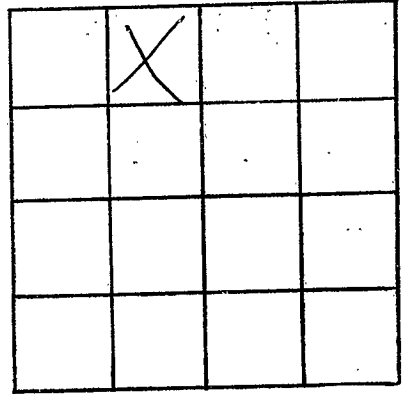

SECTION 17

Please indicate well location X.

ADDITIONAL INFORMATION

If more than one screen, show locations of each on sketch.