

WILKINSON

R 2001

11-23-75

MISSISSIPPI BOARD OF WATER COMMISSIONERS  
416 North State Street  
Jackson, Mississippi 39201


WATER WELL DRILLERS LOG

Nov. 23 1975  
date well completed

Reems Well Ser  
firm name

Wilkinson  
county well located


LANDOWNER:	description of formations encountered	from	to
John Reems	Blue Chalk	0	26
Woodville (mailing address)	Blue mud	26	118
WELL LOCATION:	Lime Sand	118	130
sec. 7 T 2 N R 4 E 6 miles north of Fadalou (distance) (direction) (nearest town)	Crash Sand	130	142
WELL PURPOSE: Industrial (home, irrigation, municipal, industrial)			
WELL COMPLETION DATA:			
(1) diameter (inches) 4"			
(2) total depth (feet) 142			
(3) static water level (feet) 33 below top of ground.			
(4) casing plastic, bottom (material) (depth)			
If telescope see back. (size)			
(5) screen 6" 136 (length) (depth to top)			
(6) pump 10 (HP) (yield gpm)			
Wrest (type power)			
(7) electric log No (yes or no)			
(organization running log)			
(8) how well bottom plugged Wooden plug			
DRILLERS REMARKS:			

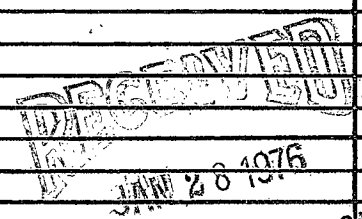

MISS. Bd. OF WATER COMMISSIONERS

If well telescopes please sketch and show depths.

GROUND LEVEL

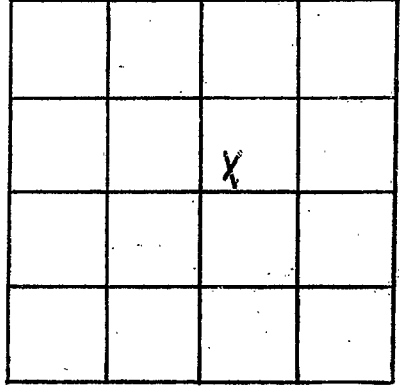

SECTION

7

Please indicate well location X.

ADDITIONAL INFORMATION

If more than one screen, show locations of each on sketch.