

W. Wilkinson
Kason
10-19-79

MISSISSIPPI
 BOARD OF WATER COMMISSIONERS
 416 North State Street
 Jackson, Mississippi 39201

WATER WELL DRILLERS LOG

10-19 1979 Rayhorn Drilling & Const. Co. Wilkinson
 date well completed firm name county well located

LANDOWNER:
Melbrook Hunting Club
Wilkinson MS.
 (mailing address)

description of formations encountered	from	to
<u>Top soil</u>	<u>0</u>	<u>2</u>
<u>redish clay</u>	<u>2</u>	<u>7</u>
<u>blue clay</u>	<u>7</u>	<u>97</u>
<u>fine sand</u>	<u>97</u>	<u>132</u>
<u>coarse sand</u>	<u>132</u>	<u>172</u>

WELL LOCATION:
 sec. 19 T 2 N R 4 E
9 miles SW of Jessley
 (distance) (direction) (nearest town)

WELL PURPOSE: Home
 (home, irrigation, municipal, industrial)

- WELL COMPLETION DATA:
- (1) diameter (inches) 2"
 - (2) total depth (feet) 172'
 - (3) static water level (feet) 70' below above top of ground.
 - (4) casing 2" 165'
 (material) (depth)
2" if telescope see back.
 (size)
 - (5) screen 5' 165'
 (length) (depth to top)
2" 155"
 (size) (material)
 - (6) pump _____
 (HP) (yield gpm)
 (type power)
 - (7) electric log _____
 (yes or no)
 (organization running log)
 - (8) how well bottom plugged well plug

DEPT. OF NATURAL RESOURCES
 BUREAU OF LAND & WATER RESOURCES


DEC 20 1979

RECEIVED

DRILLERS REMARKS: _____

If well telescopes please sketch and show depths.

GROUND LEVEL

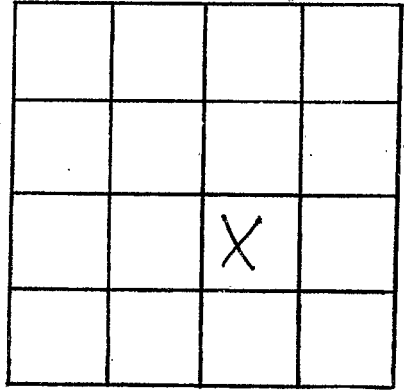

SECTION 19

Please indicate well location X.

ADDITIONAL INFORMATION

If more than one screen, show locations of each on sketch.