

MISSISSIPPI DEPARTMENT OF NATURAL RESOURCES  
 Bureau of Land and Water Resources  
 Southport Mall  
 P.O. Box 10631  
 Jackson, Mississippi 39209  
**WATER WELL DRILLERS LOG**

*Wilkinson*  
*K 2053*

*8-10-* 19 *83* *Rayburn Drilling Cont. Wilkinson*  
 date well completed firm name county well located

LANDOWNER:	description of formations encountered	from	to
<p><i>Mrs. William Rosenblatt</i>  <i>P.O. Box A</i>  <i>East Adams MS 391636</i>            (mailing address)</p>	<p><i>Shale + Gumbo</i>  <i>Sand</i></p>	<p><i>0</i>  <i>136</i></p>	<p><i>185</i>  <i>200</i></p>
<p><b>WELL LOCATION:</b>            sec. <i>46</i> T <i>2</i> N R <i>4</i> E  <i>1/2</i> miles <i>NE</i> of <i>Fruitadorn</i>            (distance) (direction) (nearest town)</p>			
<p><b>WELL PURPOSE:</b> <i>Private</i>            (home, irrigation, municipal, industrial)</p>			
<p><b>WELL COMPLETION DATA:</b></p>			
<p>(1) diameter (inches) <i>4"</i></p>			
<p>(2) total depth (feet) <i>200 ft.</i></p>			
<p>(3) static water level (feet) <i>65</i> below above top of ground.</p>			
<p>(4) casing <i>PVC</i>, <i>185 ft</i>            (material) (depth)  <i>4"</i>            (size) if telescope see back.</p>			
<p>(5) screen <i>15 ft</i>, <i>185 ft</i>            (length) (depth to top)  <i>4"</i>, <i>PVC</i>            (size) (material)</p>			
<p>(6) pump <i>3/4</i>, <i>14 GPM</i>            (HP) (yield gpm)  <i>elec</i>            (type power)</p>			
<p>(7) electric log <i>NO</i>            (yes or no)</p>			
<p>(organization running log)</p>			
<p>(8) how well bottom plugged <i>Wood Plug</i></p>			
<p>DRILLERS REMARKS:</p>			


DEPT. OF NATURAL RESOURCES  
 BUREAU OF LAND & WATER RESOURCES

AUG 15 1983

**RECEIVED**

If well telescopes please sketch and show depths.

GROUND LEVEL

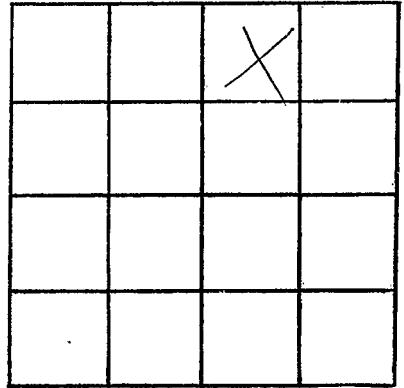

SECTION 76

Please indicate well location X.

ADDITIONAL INFORMATION

If more than one screen,  
show locations of each on sketch.