

MISSISSIPPI DEPARTMENT OF NATURAL RESOURCES

Bureau of Land and Water Resources

Southport Mall

P.O. Box 10631

Jackson, Mississippi 39209

WATER WELL DRILLERS LOG

Wilkinson
K K
0005

11 4 1983
date well completed

B & F Drilling Inc
firm name

Wilkinson
county well located

LANDOWNER:
Energy Drilling
Natchez Miss
(mailing address)

description of formations encountered	from	to
Top Soil	0	10
Gumbo Soil	10	60
Sand	60	140

WELL LOCATION:
sec. 24 T 2 N R 4 W
5 miles W of Fort Adams
(distance) (direction) (nearest town)

WELL PURPOSE: Supply
(home, irrigation, municipal, industrial)

- WELL COMPLETION DATA:
- (1) diameter (inches) 3"
 - (2) total depth (feet) 140'
 - (3) static water level (feet) 10' below top of ground.
 - (4) casing Plastic, 130'
(material) (depth)
if telescope see back.
(size)
 - (5) screen 10' 130'
(length) (depth to top)
3' Plastic
(size) (material)
 - (6) pump (HP) (yield gpm)
Air
(type power)
 - (7) electric log (yes or no)
(organization running log)
 - (8) how well bottom plugged Cap

DRILLERS REMARKS: Pulled
Back Piled


DEPT. OF NATURAL RESOURCES
BUREAU OF LAND & WATER RESOURCES

DEC - 1 1983

RECEIVED

If well telescopes please sketch and show depths.

GROUND LEVEL

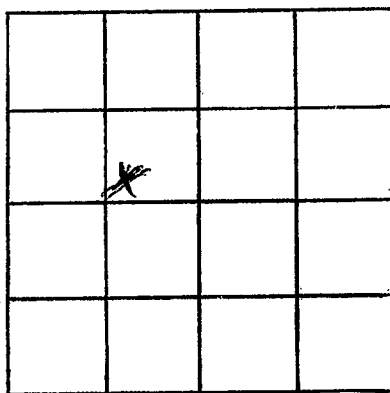

SECTION _____

Please indicate well location X.

ADDITIONAL INFORMATION

If more than one screen,
show locations of each on sketch.