

Wilkeyson
K K
3000

MISS

For owner
I put
Shamrock
Is this
right?

NATURAL RESOURCES
Resources
1
39209
S LOG

11-29-83 19 05
date well completed

firm name

Willverson
county well located

LANDOWNER: Unknown	description of formations encountered	from	to
wellowner Shamrock			
Drilling Co. Natchez, Miss (mailing address)	coarse sand	11D	11D
WELL LOCATION:			
sec. 17 T 9 N R 4 E S W			
8 miles West of Fort Adam (distance) (direction) (nearest town)			
WELL PURPOSE: Pond (home, irrigation, municipal, industrial)			
WELL COMPLETION DATA:			
(1) diameter (inches) 5			
(2) total depth (feet) 180'			
(3) static water level (feet) 11 below above top of ground.			
(4) casing Plastic, 100' (material) (depth)			
3" if telescope see back. (size)			
(5) screen 10, 100 (length) (depth to top)			
3", Plastic (size) (material)			
(6) pump none (HP) (yield gpm)			
(type power)			
(7) electric log (yes or no)			
(organization running log)			
(8) how well bottom plugged 3" plastic cap			
DRILLERS REMARKS:			


DEPT. OF NATURAL RESOURCES
BUREAU OF LAND & WATER RESOURCES

DEC 16 1983

RECEIVED

If well telescopes please sketch and show depths.

GROUND LEVEL

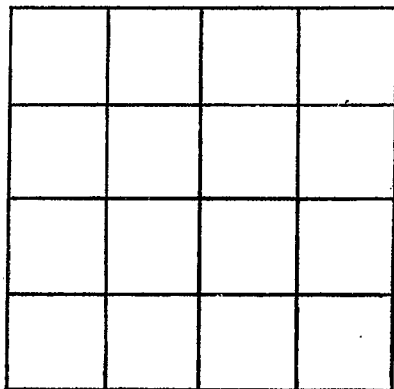

SECTION _____

Please indicate well location X.

ADDITIONAL INFORMATION

If more than one screen, show locations of each on sketch.