

William
K
2007

MIS

Jane
Lee Ford
Shamrock

NATURAL RESOURCES
ter Resources
all
31
39209
RS LOG

11-30-83 19 05
date well completed

firm name

Willvevson
county well located

LANDOWNER: Unknown

description of fomations
encountered

from

to

well owner Shamrock

loombo

0

78

Drilling co. Natchez Miss
(mailing address)

coarse sand

78

98

WELL LOCATION:

sec 23 T 2 N R 4 E
S W

miles West of Fort Adams
(distance) (direction) (nearest town)

WELL PURPOSE: Ind
(home, irrigation, municipal, industrial)

WELL COMPLETION DATA:

- (1) diameter (inches) 5
- (2) total depth (feet) 98'
- (3) static water level (feet) 16 below top of ground.
- (4) casing Plastic, 88'
(material) (depth)
- 3 (size) if telescope see back.
- (5) screen 10, 88'
(length) (depth to top)
- 3, Plastic
(size) (material)
- (6) pump @ 1.5 cpm pressure
(HP) (yield gpm)
- (type power)
- (7) electric log (yes or no)

(organization running log)

- (8) how well bottom plugged 3" Plastic cap.

DRILLERS REMARKS:


DEPT. OF NATURAL RESOURCES
BUREAU OF LAND & WATER SERVICES

DEC 16 1983

RECEIVED

If well telescopes please sketch and show depths.

GROUND LEVEL

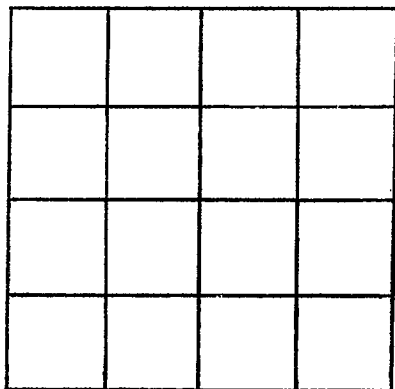

SECTION _____

Please indicate well location X.

ADDITIONAL INFORMATION

If more than one screen,
show locations of each on sketch.