

Wellson  
R  
2008

See owner  
how to get  
Drill Wells  
Inc.  
✓ for OK

DEPT OF NATURAL RESOURCES  
Water Resources  
Post Office Box  
10631  
Memphis, Tennessee 39209  
WELLERS LOG

11-22-83  
date well completed

Drill Wells Inc.  
firm name

Wellson  
county well located

LANDOWNER	description of formations encountered	from	to
Unknown Drill Wells Inc.	Silt Sand	0	100
Pt. 1 Box 407 Elm Grove, Miss. (mailing address) 39151		100	118
<b>WELL LOCATION:</b>			
sec. <u>12</u> T. <u>2</u> N. R. <u>4</u> E S W 0.1 miles West Fort Adams (distance) (direction) (nearest town)			
<b>WELL PURPOSE:</b> (home, irrigation, municipal, industrial)			
<b>WELL COMPLETION DATA:</b>			
(1) diameter (inches) <u>5</u>			
(2) total depth (feet) <u>118</u>			
(3) static water level (feet) _____ below top of ground. above			
(4) casing <u>Plastic</u> <u>118</u> (material) (depth) <u>3"</u> (size) If telescope see back.			
(5) screen <u>10</u> <u>118</u> <u>3"</u> (length) (depth to top) (size) <u>Plastic</u> (material)			
(6) pump <u>None</u> (HP) (yield gpm)			
(type power)			
(7) electric log (yes or no) _____			
(organization running log)			
(8) how well bottom plugged <u>3" pipe</u>			

DEPT OF NATURAL RESOURCES  
BUREAU OF LAND & WATER RESOURCES


DEC 16 1983

RECEIVED

DRILLERS REMARKS:

If well telescopes please sketch and show depths.

GROUND LEVEL

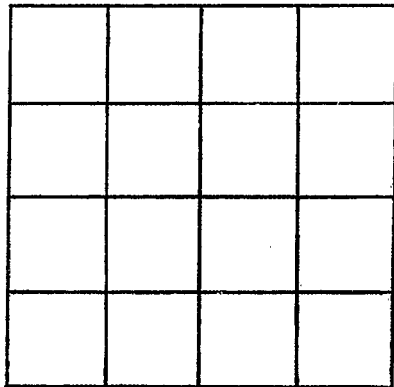

SECTION \_\_\_\_\_

Please indicate well location X.

ADDITIONAL INFORMATION

If more than one screen,  
show locations of each on sketch.