

MISSISSIPPI DEPARTMENT OF NATURAL RESOURCES

Bureau of Land and Water Resources

~~Southport Mail~~

P.O. Box 10631

Jackson, Mississippi 39209

WATER WELL DRILLERS LOG

WILKERSON
K 2014

7-25-1990 date well completed 90 O J Harris Well Service firm name WilkerSON county well located

LANDOWNER: Shamrock Drilling
P.O. Box 2210
Natchez, MS
(mailing address)

description of formations encountered

from	to
0	68
68	117

Clumbo
coarse sand

WELL LOCATION:
sec. 27 T-20 N S R-4 E W
17 miles E of Woodville
(distance) (direction) (nearest town)

WELL PURPOSE: Rig supply
(home, irrigation, municipal, industrial)

- WELL COMPLETION DATA:
- (1) diameter (inches) 3
 - (2) total depth (feet) 117
 - (3) static water level (feet) 18 below above top of ground.
 - (4) casing PVC, 107,
(material) (depth)
3in if telescope see back.
(size)
 - (5) screen 10ft, 107
(length) (depth to top)
3in, PVC
(size) (material)
 - (6) pump _____ (HP) _____ (yield gpm)
air
(type power)
 - (7) electric log no
(yes or no)

(organization running log)
 - (8) how well bottom plugged PVC cap

RECEIVED


AUG 02 1990

Department of Natural Resources
Bureau of Land & Water Resources

DRILLERS REMARKS:

If well telescopes please sketch and show depths.

GROUND LEVEL

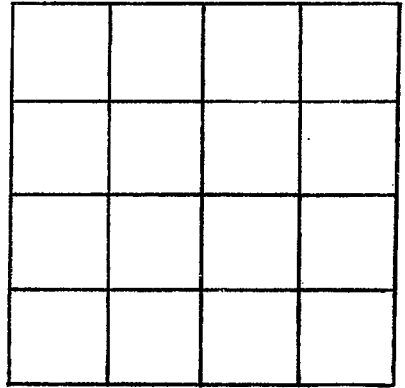

SECTION _____

Please indicate well location X.

ADDITIONAL INFORMATION

If more than one screen,
show locations of each on sketch.