

WILKINSON
K 2014

Again Ace
in sect.
Everything in
but the
sect


OF NATURAL RESOURCES
Water Resources
Mail
10631
Mississippi 39209
WELLERS LOG

10-5-1990
date well completed

firm name

Willkerson
county well located

LANDOWNER: <u>Shamrock Drilling</u>	description of formations encountered	from	to
<u>P.O. Box 2210</u>			
<u>Natchez MS 39120</u> (mailing address)	<u>Gumbo</u>	<u>0</u>	<u>115</u>
	<u>coarse sand</u>	<u>115</u>	<u>130</u>
WELL LOCATION:			
sec. <u>ACT 2</u> ^N _S R. <u>4</u> ^E _W			
<u>3</u> miles <u>SW</u> of <u>Lake Mary</u>			
(distance) (direction) (nearest town)			
WELL PURPOSE: <u>rig supply</u> (home, irrigation, municipal, industrial)			
WELL COMPLETION DATA:			
(1) diameter (inches) <u>3in.</u>			
(2) total depth (feet) <u>130</u>			
(3) static water level (feet) <u>16</u> ^{below} _{above} top of ground.			
(4) casing <u>PVC, 120</u> (material) (depth)			
<u>3in</u> (size) if telescope see back.			
(5) screen <u>10ft, 120</u> (length) (depth to top)			
<u>3in</u> , <u>PVC</u> (size) (material)			
(6) pump <u>air</u> (HP) (yield gpm)			
(type power)			
(7) electric log <u>no</u> (yes or no)			
(organization running log)			
(8) how well bottom plugged <u>PVC cap.</u>			
DRILLERS REMARKS:			

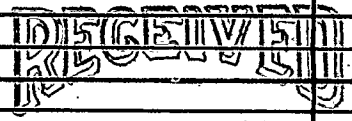


NOV 02 1990

Department of Natural Resources
Bureau of Land & Water Resources

If well telescopes please
sketch and show depths.

GROUND LEVEL

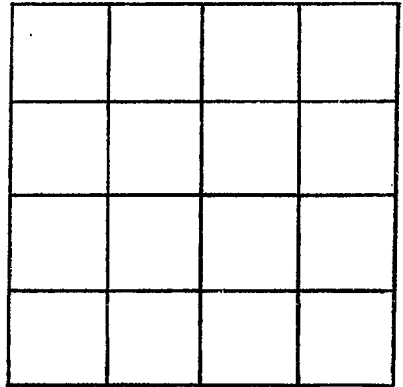

SECTION _____

Please indicate well location X.

ADDITIONAL INFORMATION

If more than one screen,
show locations of each on sketch.