

MISSISSIPPI DEPARTMENT OF ENVIRONMENTAL QUALITY

Office of Land and Water Resources

P. O. Box 10631

Jackson, MS 39289-0631

WATER WELL DRILLERS LOG

COUNTY WELL LOCATED Wilkinson	
WELL NUMBER K-2019	CODED
DATE WELL COMPLETED 10-26-00	

PERMIT NUMBER 0-60
NAME OF DRILLING FIRM Rayborn Drilling, Inc.

NAME & MAILING ADDRESS OF LANDOWNER Shamrock Drilling			
118 L. Woodville Rd. Suite 2			
Natchez, MS 39120			
WELL LOCATION:	SEC	TOWNSHIP	RANGE
	8	2	5
DISTANCE 7 Miles	DIRECTION NW	NEAREST TOWN Ft. Adams	
OTHER LANDMARK			
WELL PURPOSE: Home, Irrigation, Municipal, Industrial, Fish Pond, etc. Oilfield			

PUMP DATA		
PUMP TYPE (Circle One): Submersible, Turbine, Jet, Flowing Well, Other (Describe) Air lift		
POWER TYPE (Circle One): Electric, Tractor, Diesel, Gasoline, Butane, Other (Describe) H/P		
Pump Capacity (GPM)	No. of Stages	Setting Depth FT.
PUMP TEST		
Well yielded _____ GPM with a drawdown of _____ ft. after _____ hours of pumping		

WELL DATA		
Well Depth 120	Casing Diameter (In.) 3	Casing Length (Ft.) 100
Type of Casing PVC	Hole Depth 120	Depth to Static Water Level 30
TYPE OF COMPLETION: (Circle One or More): Gravel Packed, Underreamed, Telescoped, Natural Development , Open Hole, Other		

LOG DATA	
TYPE OF LOG RUN (Circle One): No Log Run, Electric, Gamma Ray, Density, Sonic, Neutron, Other (Describe) _____	
Name of Organization Running Log	

WELL GROUTED TO A DEPTH OF 10 FEET
Type Grout (circle one): Cement, Bentonite, or Mix

GEOLOGIC DATA (Office Use Only)			
Surface Elev.	Geologic Unit	Unit Thickness	Depth to Top
Subs. SWL	Date	Analysis	Aquifer Test

SCREEN DATA		
Diameter - Inches 3	Length - Feet 20	Slot Size - Inches .020
Screen Type PVC	Depth to Bottom - Feet 120	


Driller's Remarks
Top of Lap Pipe or Reduction in Casing FEET IF TELESCOPED OR MORE THAN ONE SCREEN: USE BACK PAGE

DESCRIPTION OF FORMATIONS ENCOUNTERED	FROM	TO
River Sand	0	2
Sambo Sand	2	40
Sand	40	120

FORMATIONS (Continued)	FROM	TO
112 GSW		
NOV 06 2000		
Dept. of Environmental Quality		
Office of Land & Water Resources		

If well telescopes please sketch and show depths.

GROUND LEVEL

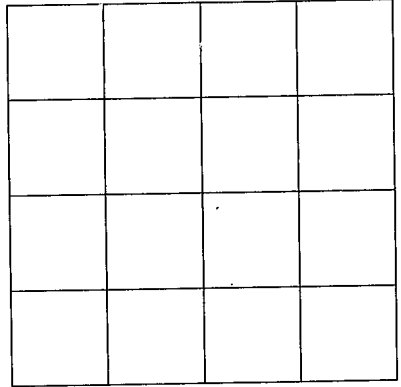

SECTION _____

Please indicate well location X.

ADDITIONAL INFORMATION

If more than one screen,
show location of each on sketch.