

WILKINSON
L 6
10-31-72

MISSISSIPPI
BOARD OF WATER COMMISSIONERS
416 North State Street
Jackson, Mississippi 39201

CODED

WATER WELL DRILLERS LOG

Wilkenson

Oct 31 1972 date well completed
Chotek Keener firm name
county well located

LANDOWNER: Opheelia
Scrunkall
Woodville
(mailing address)

description of formations encountered	from	to
Clay	0	14
Red Sand gravel	14	42
white chalk	42	127
white sand	127	140

WELL LOCATION:
sec. 54 T. 2 N. R. 3 E
9 miles W Woodville
(distance) (direction) (nearest town)

WELL PURPOSE: Home
(home, irrigation, municipal, industrial)

WELL COMPLETION DATA:
(1) diameter (inches) 2"
(2) total depth (feet) 141
(3) static water level (feet) 90 below above top of ground.
(4) casing Steel, bottom
(material) (depth)

if telescope see back.
(size)

(5) screen 5', 136'
(length) (depth to top)
1/2" slotted steel
(size) (material)

(6) pump old Kohler
(HP) (yield gpm)

(type power)

(7) electric log NO
(yes or no)

(organization running log)

(8) how well to be plugged
well screen


DRILLERS REMARKS:
old 2" well
sanded

CODED

MISS. BD. OF
WATER COMMISSIONERS

If well telescopes please sketch and show depths.

GROUND LEVEL

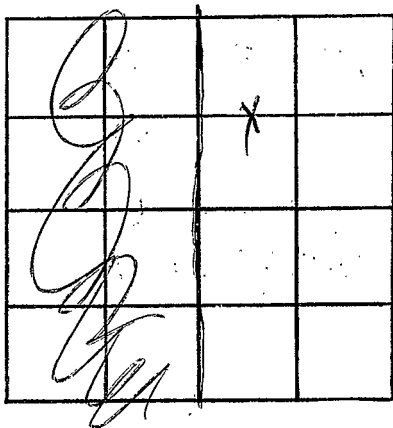

SECTION 54

Please indicate well location X.

ADDITIONAL INFORMATION

If more than one screen, show locations of each on sketch.