

WILKINSON

L 12

10-16-80

Bureau of Land and Water Resources

Southport Mall

P.O. Box 10631

Jackson, Mississippi 39209

WATER WELL DRILLERS LOG

CODED

Oct 16 1980
date well completed

Reenswell & Wilkinson
firm name

Wilkinson
county well located

LANDOWNER:

Frank Bell

Woodville
(mailing address)

description of formations encountered

from

to

Red clay	0	18
Red sand & clay	18	90
Gravel & sand	90	103
Blue clay	103	204
pea gravel & sand	204	213

WELL LOCATION:

sec. 62 T 2 N R 3 E W
1/2 miles west of Woodville
(distance) (direction) (nearest town)

WELL PURPOSE:

none
(home, irrigation, municipal, industrial)

WELL COMPLETION DATA:


- (1) diameter (inches) 4"
- (2) total depth (feet) 213
- (3) static water level (feet) 175' below top of ground
- (4) casing plastic batton
(material) (depth)
- (size) If telescope see back.
- (5) screen 5', 208'
(length) (depth to top)
- (size) 4", plastic
(material)
- (6) pump 3 sub, 1"
(HP) (yield gpm)
- (type power) elect
- (7) electric log no
(yes or no)
- (organization running log)

CODED

(8) how well bottom plugged


back wash

DRILLERS REMARKS:

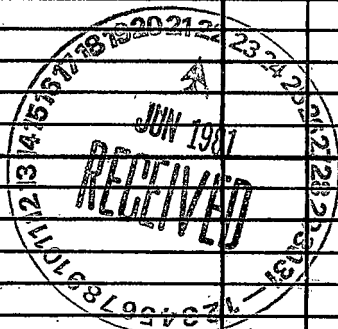

If well telescopes please sketch and show depths.

GROUND LEVEL

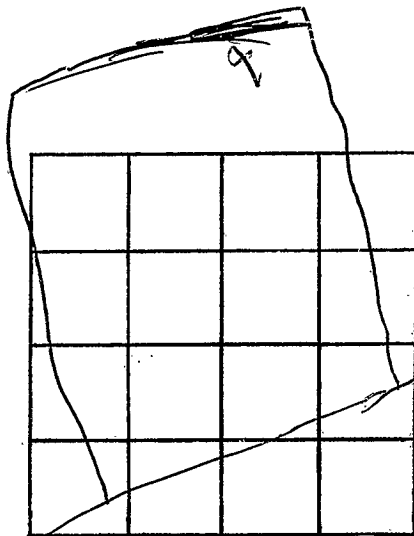

SECTION 62

Please indicate well location X.

ADDITIONAL INFORMATION

If more than one screen,
show locations of each on sketch.