

MISSISSIPPI DEPARTMENT OF NATURAL RESOURCES

Bureau of Land and Water Resources

Southport Mall

P.O. Box 10631

Jackson, Mississippi 39209

WATER WELL DRILLERS LOG

WILKINSON  
L 14 L  
1/20/83

1-20 1983 Raymond Drilling Wilkinson  
 date well completed firm name county well located

LANDOWNER:  
Raymond Drilling Co.  
Jessiday La  
 (mailing address)

description of formations encountered	from	to
<u>top soil</u>	<u>0</u>	<u>5</u>
<u>clay</u>	<u>5</u>	<u>400</u>
<u>sand</u>	<u>400</u>	<u>474</u>

WELL LOCATION:  
 sec. 6 T. 2 N. R. 3 E.  
 S. W.

\_\_\_\_\_ miles \_\_\_\_\_ of \_\_\_\_\_  
 (distance) (direction) (nearest town)

WELL PURPOSE:  
 (home, irrigation, municipal, industrial)

#1 Kathleen O'Fallon

WELL COMPLETION DATA:

(1) diameter (inches) 3"

(2) total depth (feet) 474

(3) static water level (feet) 100' <sup>below</sup> above top of ground.

(4) casing PVC, 454'  
 (material) (depth)

3"  
 (size) if telescope see back.

(5) screen 20', 454'  
 (length) (depth to top)

3", slotted pipe  
 (size) (material)

(6) pump — 40  
 (HP) (yield gpm)

elec.  
 (type power)

(7) electric log no  
 (yes or no)

\_\_\_\_\_ (organization running log)

(8) how well bottom plugged wood plug

1  
176° N ± 345' W of SE 1/4  
LOT 2 (From NE 1/4)

**CODED**

DEPT. OF NATURAL RESOURCES  
 BUREAU OF LAND & WATER RESOURCES


FEB 22 1983

**RECEIVED**

DRILLERS REMARKS:

If well telescopes please sketch and show depths.

GROUND LEVEL

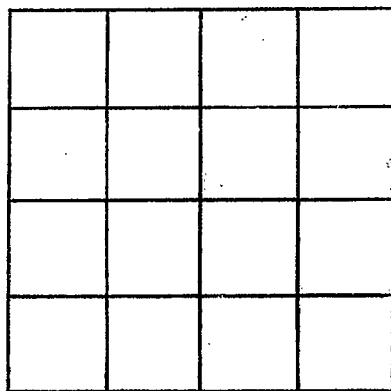

SECTION \_\_\_\_\_

Please indicate well location X.

ADDITIONAL INFORMATION

If more than one screen, show locations of each on sketch.