

MISSISSIPPI DEPARTMENT OF NATURAL RESOURCES

Bureau of Land and Water Resources

Southport Mall

P.O. Box 10631

Jackson, Mississippi 39209

WATER WELL DRILLERS LOG

**CODED**

L15  
Wilkinson  
9-10-83

9-10-83  
date well completed

Griner Drilling Service, Inc.  
firm name

Wilkinson  
county well located

LANDOWNER:	description of formations encountered	from	to
Marion Corporation P.O. Box 3027 Daphne, Ala. 36526 (mailing address)	Clay, sand sand, gravel Clay	0 42 105	42 105 147
WELL LOCATION: 1801' N + 416' E Spc. 44 T 20 R 3 E SW/40 J. A. Vess Woodville 1/4 sec. (distance) miles (direction) of (nearest town)	sand streaked rock streaked chalk sand, chalk sand	147 168 231 378 420	168 231 378 420 483
WELL PURPOSE: oil field supply (home, irrigation, municipal, industrial)	chalk, some sand sand, pea gravel	483 630	630 694

WELL COMPLETION DATA:

- (1) diameter (inches) 3"
- (2) total depth (feet) 694'
- (3) static water level (feet) 300' <sup>below</sup> <sub>above</sub> top of ground.
- (4) casing Steel, 694'  
(material) (depth)  
3"  
(size) if telescope see back.
- (5) screen 42', 652'  
(length) (depth to top)  
3", perforated  
(size) (material)
- (6) pump 40  
(HP) (yield gpm)  
AC  
(type power)
- (7) electric log \_\_\_\_\_  
(yes or no)  
\_\_\_\_\_  
(organization running log)
- (8) how well bottom plugged Orange peel

DRILLERS REMARKS:


DEPT. OF NATURAL RESOURCES  
BUREAU OF LAND & WATER RESOURCES

OCT 3 1983

RECEIVED

If well telescopes please sketch and show depths.

GROUND LEVEL

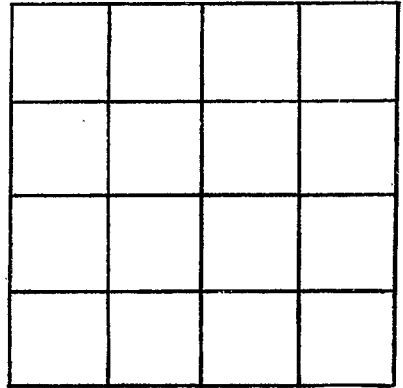

SECTION \_\_\_\_\_

Please indicate well location X.

ADDITIONAL INFORMATION

If more than one screen, show locations of each on sketch.