

MISSISSIPPI DEPARTMENT OF NATURAL RESOURCES

Bureau of Land and Water Resources

Southport Mall

P.O. Box 10631

Jackson, Mississippi 39209

WATER WELL DRILLERS LOG

CODED

L16  
 WILKINSON  
 10-19-83

10-19-83 date well completed      Rayborn Drill & Const. Co. firm name      Wilkinson county well located


| LANDOWNER:   | description of formations encountered  | from | to  |
|--|--|------|-----|
| David. New Drilling Co, Inc.<br>Natchez, ms 39120<br>(mailing address)     |  |      |     |
| WELL LOCATION:<br>sec. 17 T. 2 N. S. R. 3 E. W.                            | sand   | 20   | 25  |
| (distance) miles (direction) of (nearest town)                             | gumbo  | 25   | 140 |
| WELL PURPOSE:<br>(home, irrigation, municipal, industrial)                 | sand   | 140  | 170 |
| WELL COMPLETION DATA:  | gumbo  | 170  | 240 |
| (1) diameter (inches) 3"   | streaked sand  | 240  | 270 |
| (2) total depth (feet) 325'  | sand   | 270  | 325 |
| (3) static water level (feet) 150' below top of ground.                    |  |      |     |
| (4) casing Blk, 305' (material), (depth), 3" (size) if telescope see back. | Row  |      |     |
| (5) screen 20' (length), 305' (depth to top), 4" (size), Blk (material)    | "PES" #1   |      |     |
| (6) pump (HP) 52 Gpm (yield gpm)   | FR NW/4 sec 17, QD SE dlg N/ boundary for 1780' to SW 1/4 C. RA 0524' to loc |      |     |
| (7) electric log no (yes or no)  |  |      |     |
| (organization running log)   |  |      |     |
| (8) how well bottom plugged wood plug                                      |  |      |     |
| DRILLERS REMARKS:  |  |      |     |

DEPT. OF NATURAL RESOURCES  
 BUREAU OF LAND & WATER RESOURCES

NOV 14 1983  
 RECEIVED

If well telescopes please  
sketch and show depths.

GROUND LEVEL

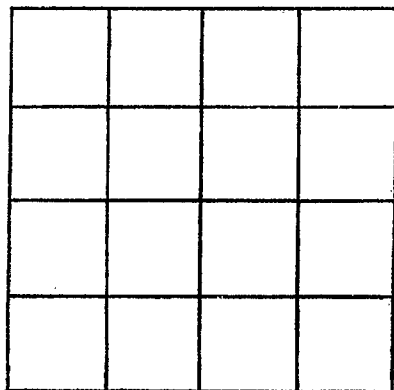

SECTION \_\_\_\_\_

Please indicate well location X.

ADDITIONAL INFORMATION

If more than one screen,  
show locations of each on sketch.