

MISSISSIPPI DEPARTMENT OF NATURAL RESOURCES
Bureau of Land and Water Resources
 Southport Mall
 P.O. Box 10631
 Jackson, Mississippi 39209
WATER WELL DRILLERS LOG

CODED

Wilkinson
L 17

Aug 23 1984 Self Drilled Water Well Driller Wilkinson
 date well completed firm name county well located

LANDOWNER: R.E. Williams
High 61 North Natchez
Me
 (mailing address)

description of formations encountered	depth	
	from	to
<u>top soil</u>	<u>0</u>	<u>25</u>
<u>chalk</u>	<u>25</u>	<u>50</u>
<u>sand + pebbles</u>	<u>50</u>	<u>130</u>

WELL LOCATION:
 sec. 8 T 2 N R 3 E
8 miles S-W of Wadville
 (distance) (direction) (nearest town)

WELL PURPOSE: for prod
 (home, irrigation, municipal, industrial)

WELL COMPLETION DATA:

(1) diameter (inches) 4"

(2) total depth (feet) 130'

(3) static water level (feet) 90' below above top of ground.

(4) casing plastic, 110'
 (material) (depth)
4"
 (size) if telescope see back.

(5) screen 20', 110'
 (length) (depth to top)
4", plastic
 (size) (material)

(6) pump 3 50
 (HP) (yield gpm)
Electric
 (type power)

(7) electric log No
 (yes or no)

(organization running log)

(8) how well bottom plugged in use

DRILLERS REMARKS:

CODED


DEPT. OF NATURAL RESOURCES
 BUREAU OF LAND & WATER RESOURCES

SEP 14 1984

RECEIVED

If well telescopes please sketch and show depths.

GROUND LEVEL

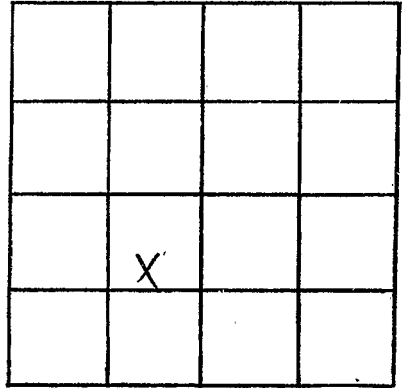

SECTION 58

Please indicate well location X.

ADDITIONAL INFORMATION

If more than one screen,
show locations of each on sketch.