

MISSISSIPPI DEPARTMENT OF NATURAL RESOURCES

Bureau of Land and Water Resources

Southport Mall

P.O. Box 10631

Jackson, Mississippi 39209

CODED

WATER WELL DRILLERS LOG

WILKINSON

L19

1/27/84 Rayborn Drilling Wilkinson

LANDOWNER:  
 Roosevelt Lee  
 1300 Roosevelt Blvd  
 Renner, LA 70068  
 (mailing address)

WELL LOCATION:  
 sec 24 T 2<sub>N</sub> R 3<sub>E</sub>  
 6 miles SE of Lumberton  
 (distance) (direction) (nearest town)

WELL PURPOSE: private  
 (home, irrigation, municipal, industrial)

WELL COMPLETION DATA:

- (1) diameter (inches) 4"
- (2) total depth (feet) 420'
- (3) static water level (feet) 180' below top of ground.
- (4) casing PVC pipe 400',  
 (material) (depth)  
4" if telescope see back.  
 (size)
- (5) screen 20' 400'  
 (length) (depth to top)  
4" PVC slotted pipe  
 (size) (material)
- (6) pump 1 11  
 (HP) (yield gpm)  
rebo  
 (type power)
- (7) electric log no  
 (yes or no)  
 \_\_\_\_\_  
 (organization running log)
- (8) how well bottom plugged wood

description of formations encountered	from to	
Top Soil	0	10
Chalk	11	180
Sand	181	189
Gumbo	190	340
Streak Sand	341	370
Sand	371	420

CODED


DEPT. OF NATURAL RESOURCES  
 BUREAU OF LAND & WATER RESOURCES

OCT 31 1984  
 RECEIVED

DRILLERS REMARKS:

If well telescopes please  
sketch and show depths.

GROUND LEVEL

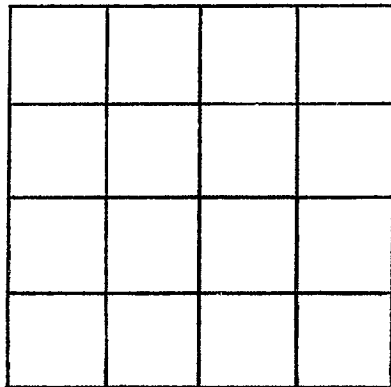

SECTION \_\_\_\_\_

Please indicate well location X.

ADDITIONAL INFORMATION

If more than one screen,  
show locations of each on sketch.