

MISSISSIPPI DEPARTMENT OF NATURAL RESOURCES

Bureau of Land and Water Resources

Southport Mall

P.O. Box 10631

Jackson, Mississippi 39209

WATER WELL DRILLERS LOG

CODED

WILKINSON
L 20
4-17-86

Griner Drilling Service, Inc.

Wilkinson


4-17-86 date well completed

Griner Drilling Service, Inc. firm name

Wilkinson county well located

LANDOWNER:	description of formations encountered	from	to
Tesoro Petroleum P.O. Box 2909 Laurel, MS, 39442 (mailing address)	chalk, rock	0	550
	sand	550	630
WELL LOCATION: 1072' N & 2500' E sec. 51 T 20 N R 3 E of No. 101 Woodville (W) sw/4 (distance) (direction) (nearest town)	chalk, rock	630	872
	sand	872	966
WELL PURPOSE: oilfield rig (home, irrigation, municipal, industrial)			
WELL COMPLETION DATA:			
(1) diameter (inches) 3"			
(2) total depth (feet) 966'			
(3) static water level (feet) 300' below top of ground.			
(4) casing steel 966' (material) (depth)			
3" if telescope see back. (size)			
(5) screen 63' 903' (length) (depth to top)			
3" perforated (size) (material)			
(6) pump - 60 (HP) (yield gpm)			
AC (type power)			
(7) electric log (yes or no) <input checked="" type="radio"/> no			
(organization running log)			
(8) how well bottom plugged orange peel			
DRILLERS REMARKS:			

CODED

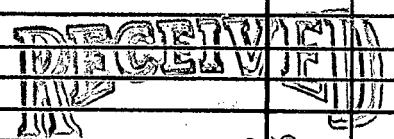


JUN 17 1986

Department of Natural Resources
Bureau of Land & Water Resources

If well telescopes please sketch and show depths.

GROUND LEVEL

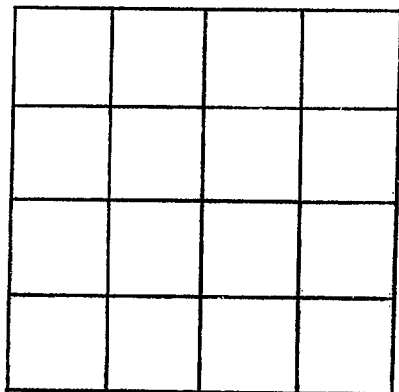

SECTION _____

Please indicate well location X.

ADDITIONAL INFORMATION

If more than one screen,
show locations of each on sketch.