

Wilkinson  
L 22  
CODED

MISSISSIPPI DEPARTMENT OF NATURAL RESOURCES  
 Bureau of Land and Water Resources  
 Southport Mall  
 P.O. Box 10631  
 Jackson, Mississippi 39209  
**WATER WELL DRILLERS LOG**

5/22/88 19 MAURICE PRO. INC. Wilkinson  
 date well completed firm name county well located

LANDOWNER: AKULA EXPL.  
CO - SHREVEPORT, LA  
 (mailing address)

WELL LOCATION:  
 sec. 46-T-2(N) R-3E  
7 miles SOUTH of WABAMMOO  
 (distance) (direction) (nearest town)

WELL PURPOSE: RIA SUPPLY  
 (home, irrigation, municipal, industrial)

WELL COMPLETION DATA:

- (1) diameter (inches) 7 7/8
- (2) total depth (feet) 680 FT
- (3) static water level (feet) 300 <sup>below</sup> above top of ground.
- (4) casing STEEL (material), 660' (depth)  
4" (size) if telescope see back.
- (5) screen 21' (length), 660' (depth to top)  
4 (size), S.S. (material)
- (6) pump 7 1/2 (HP), 50 GPM (yield gpm)  
ELECTRIC (type power)
- (7) electric log No (yes or no)  
WIA (organization running log)
- (8) how well bottom plugged 4"  
BACK WASH VALVE

description of formations encountered	from	to
<u>Red Clay - Sway Gill</u>	<u>0</u>	<u>100'</u>
<u>CLAY</u>	<u>100</u>	<u>160</u>
<u>Sway Clay - RKS</u>	<u>160</u>	<u>300</u>
<u>SHALE</u>	<u>300</u>	<u>320</u>
<u>Sway Clay</u>	<u>320</u>	<u>340</u>
<u>SAND - CLAY STRIATIONS</u>	<u>340</u>	<u>380</u>
<u>Sway Clay - RKS</u>	<u>380</u>	<u>500</u>
<u>MEDIUM SAND</u>	<u>500</u>	<u>680</u>

**RECEIVED**  
 JUN 20 1988

Department of Natural Resources  
 Bureau of Land & Water Resources


DRILLERS REMARKS:

If well telescopes please sketch and show depths.

GROUND LEVEL

66 FT  
4" STEEL

20 FT  
• 025  
S.S. SCREEN

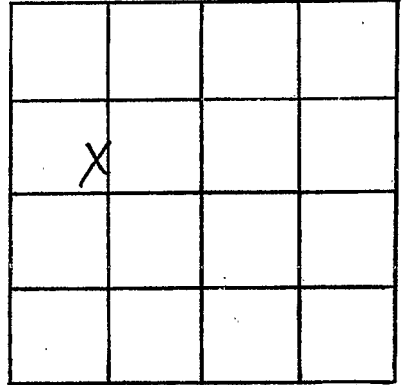

SECTION 46

Please indicate well location X.

ADDITIONAL INFORMATION

If more than one screen, show locations of each on sketch.