

WILKINSON

L 2000

2-5-76

MISSISSIPPI BOARD OF WATER COMMISSIONERS
416 North State Street
Jackson, Mississippi 39201

14E

WATER WELL DRILLERS LOG

2-5-76

Omite Pump & Well Supply, Wilkinson

date well completed

firm name

county well located

LANDOWNER:

A. P. Bedgood

description of formations encountered

from

58

Rt 2 Box 800 Woodville, Miss.
(mailing address)

Clay

70

58

Gravel + Sand

58

63

White Clay

63

220

Fine Sand

220

226

Blue clay

226

390

Shale (type that breaks)

290

525

Hard Sand

525

560

WELL LOCATION:

sec. 52 T. 2 N. R. 14 E. W. 3
120 miles W. of Woodville
(distance) (direction) (nearest town)

WELL PURPOSE:

Home
(home, irrigation, municipal, industrial)

WELL COMPLETION DATA:

- (1) diameter (inches) 2"
- (2) total depth (feet) 560
- (3) static water level (feet) 210 below top of ground.
- (4) casing PVC, 560 (material), (depth)
2" (size) if telescope see back.
- (5) screen 30', 530' (length), (depth to top)
2" (size), PVC (material)
- (6) pump 5HP, Air Comp. (HP), (yield gpm)
elec. (type power)
- (7) electric log No. (yes or no)

(organization running log)


(8) how well bottom plugged Back Wash Filter

DRILLERS REMARKS:

RECEIVED
FEB 9 - 1976

If well telescopes please sketch and show depths.

GROUND LEVEL

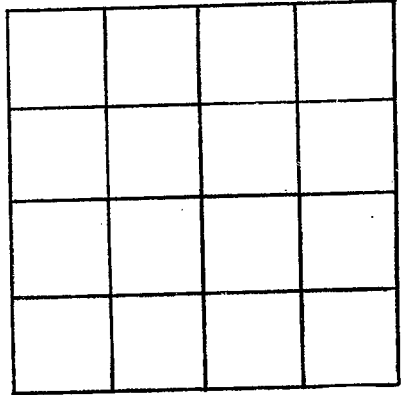

SECTION _____

Please indicate well location X.

ADDITIONAL INFORMATION

If more than one screen,
show locations of each on sketch.