

MISSISSIPPI DEPARTMENT OF NATURAL RESOURCES

Bureau of Land and Water Resources

Southport Mall

P.O. Box 10631

Jackson, Mississippi 39209

WATER WELL DRILLERS LOG

Wilkinson  
L  
2001

Oct-14 1981 Reynolds Miller Wilkinson  
 date well completed firm name county well located

LANDOWNER:  
La Grange Camp  
Woodville  
 (mailing address)

description of formations encountered	from	to
<u>clay</u>	<u>18</u>	<u>17</u>
<u>Red sand</u>	<u>65</u>	<u>64</u>
<u>fine gravel</u>	<u>87</u>	<u>110</u>
<u>pink chert</u>	<u>105</u>	<u>119</u>
<u>Coarse sand</u>		

WELL LOCATION:  
 sec 62 T 2 N R 3 E  
5 miles west of Woodville  
 (distance) (direction) (nearest town)

WELL PURPOSE: Camp  
 (home, irrigation, municipal, industrial)

- WELL COMPLETION DATA:
- (1) diameter (inches) 4"
  - (2) total depth (feet) 119
  - (3) static water level (feet) 100 below top of ground
  - (4) casing plastic, galton  
 (material) (depth)  
5 if telescope see back.  
 (size)
  - (5) screen 1 1/2" x 1 1/2"  
 (length) (depth to top)  
1 1/2" plastic  
 (size) (material)
  - (6) pump 1/2 cellular  
 (HP) (yield gpm)  
split  
 (type power)
  - (7) electric log no  
 (yes or no)  
 (organization running log)

DEPT. OF NATURAL RESOURCES  
 BUREAU OF LAND & WATER RESOURCES


JUN 15 1982

RECEIVED

(8) has well bottom plugged back west  
 DRILLERS REMARKS:

If well telescopes please sketch and show depths.

GROUND LEVEL

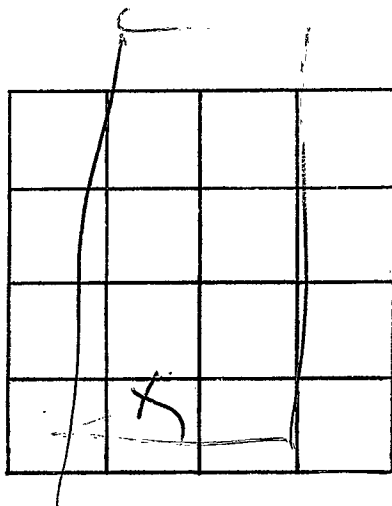

SECTION 62

Please indicate well location X.

ADDITIONAL INFORMATION

If more than one screen,  
show locations of each on sketch.