

MISSISSIPPI DEPARTMENT OF NATURAL RESOURCES

Bureau of Land and Water Resources

Southport Mall

P.O. Box 10631

Jackson, Mississippi 39209

WATER WELL DRILLERS LOG

Wilkinson
L 2002

8-1 1982 Rayborn Drilling Wilkinson
 date well completed firm name county well located

LANDOWNER:
New & Hughes
Natchez, MS
 (mailing address)

description of formations encountered	from	to
<u>top soil</u>	<u>0</u>	<u>2</u>
<u>clumps</u>	<u>2</u>	<u>15</u>
<u>gravel</u>	<u>15</u>	<u>60</u>

WELL LOCATION:
 sec. 4 T. 2 (N) R. 3 (E)
 S W
 miles _____ of _____
 (distance) (direction) (nearest town)

W.A. Jackson E 701-4-14

WELL PURPOSE:
 (home, irrigation, municipal, industrial)

WELL COMPLETION DATA:

(1) diameter (inches) 3"

(2) total depth (feet) 60'

(3) static water level (feet) 15' below top of ground above

(4) casing blk 40'
 (material) (depth)
3" if telescope see back.
 (size)

(5) screen 20' 40'
 (length) (depth to top)
3" stainless pipe
 (size) (material)

(6) pump — 45
 (HP) (yield gpm)
elec
 (type power)

(7) electric log —
 (yes or no)

(organization running log)

(8) how well bottom plugged wood plug

DEPT. OF NATURAL RESOURCES
 BUREAU OF LAND & WATER RESOURCES


SEP - 2 1982

DRILLERS REMARKS:

RECEIVED

If well telescopes please sketch and show depths.

GROUND LEVEL

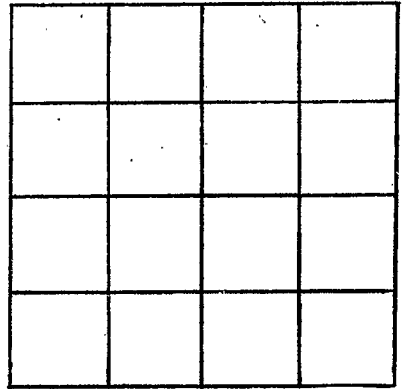

SECTION _____

Please indicate well location X.

ADDITIONAL INFORMATION

If more than one screen,
show locations of each on sketch.