

MISSISSIPPI DEPARTMENT OF NATURAL RESOURCES

Bureau of Land and Water Resources

Southport Mall

P.O. Box 10631

Jackson, Mississippi 39209

WATER WELL DRILLERS LOG

WILKINSON  
L 2004

Aug. 30 1988  
 date well completed

Reems Well Serv.  
 firm name

Wilkinson  
 county well located

LANDOWNER:  
Richard Drew  
RT Leblond Lesley  
 (mailing address)

| description of formations encountered | from       | to         |
|---------------------------------------|------------|------------|
| <u>clay</u>                           | <u>0</u>   | <u>26</u>  |
| <u>sand &amp; gravel</u>              | <u>26</u>  | <u>65</u>  |
| <u>blue chalk</u>                     | <u>65</u>  | <u>305</u> |
| <u>fine sand</u>                      | <u>305</u> | <u>350</u> |
| <u>med. coarse sand</u>               | <u>350</u> | <u>368</u> |

WELL LOCATION:  
 sec. 11 T. 2 N. R. 3 E.  
3 miles West of Lesley  
 (distance) (direction) (nearest town)

WELL PURPOSE: Home  
 (home, irrigation, municipal, industrial)

- WELL COMPLETION DATA:
- (1) diameter (inches) 4"
  - (2) total depth (feet) 368
  - (3) static water level (feet) 80 below top of ground
  - (4) casing plastic (material) bottom (depth)
  - (5) screen 10' (length) 358' (depth to top)
  - (6) pump 1/2 (HP) 10 (yield gpm)
  - (7) electric log no (yes or no)
  - (8) how well bottom plugged back wash


RECEIVED  
 JUN 27 1988

Department of Natural Resources  
 Bureau of Land & Water Resources

DRILLERS REMARKS:  
 \_\_\_\_\_

If well telescopes please sketch and show depths.

GROUND LEVEL

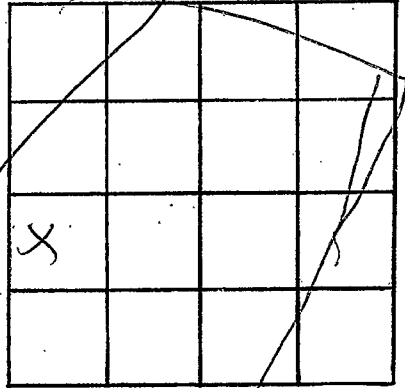

SECTION 11

Please indicate well location X.

ADDITIONAL INFORMATION

If more than one screen,  
show locations of each on sketch.