

MISSISSIPPI DEPARTMENT OF NATURAL RESOURCES
 Bureau of Land and Water Resource
 Southport Mall
 P.O. Box 10631
 Jackson, Mississippi 39209
WATER WELL DRILLERS LOG

Wilkinson
L 2007

6-1 1987 date well completed RAYBORN DRILLING, INC. firm name Wilkinson county well located

LANDOWNER: Ed Lundia, Jr.
PO Box 14236
Baton Rouge LA 70898
 (mailing address)

description of formations encountered	from	to
<u>Top Soil</u>	<u>0</u>	<u>5</u>
<u>Chalk</u>	<u>5</u>	<u>240</u>
<u>Fine sand</u>	<u>240</u>	<u>255</u>
<u>Chalk</u>	<u>255</u>	<u>305</u>
<u>Sand</u>	<u>305</u>	<u>360</u>

WELL LOCATION:
 sec. 3 T. 20 S. R. 3 E. W
10 miles E of Woodville
 (distance) (direction) (nearest town)

WELL PURPOSE: home
 (home, irrigation, municipal, industrial)

WELL COMPLETION DATA:

- (1) diameter (inches) 4"
- (2) total depth (feet) 360'
- (3) static water level (feet) 200' below top of ground.
- (4) casing Sch 40 PVC 350'
 (material) (depth)
4"
 (size) if telescope see back.
- (5) screen 10' 350'
 (length) (depth to top)
4" Slofted Sch 40 PVC
 (size) (material)
- (6) pump 1 15
 (HP) (yield gpm)
electric
 (type power)
- (7) electric log no
 (yes or no)
—
 (organization running log)
- (8) how well bottom plugged wood

RECEIVED


JUN 24 1987

Department of Natural Resources
 Bureau of Land & Water Resources

DRILLERS REMARKS:

If well telescopes please
sketch and show depths.

GROUND LEVEL

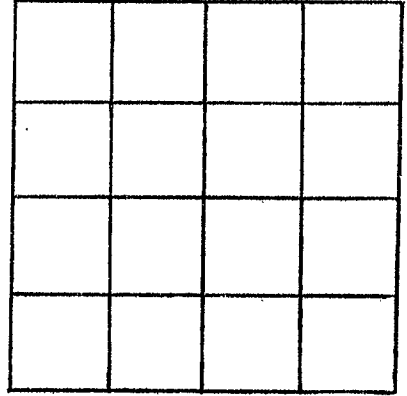

SECTION _____

Please indicate well location X.

ADDITIONAL INFORMATION

If more than one screen,
show locations of each on sketch.