

WILK,
MA
2-13-64

MISSISSIPPI BOARD OF WATER COMMISSIONERS

GW02809

WATER WELL DRILLERS LOG

CODED

CODED

Date: 2-13-, 1964, Driller: Layne-Central Co. County Wilkinson
(Name)

(1) Owner of Land: Town of Woodville
(Name)
Woodville, Mississippi

(2) Location: 1/4, 1/4, Sec. 21 28 T^N R^{2W}
38
_____ miles _____, of _____
(distance) (direction) (Nearest Town)

(3) Topography: _____
(Hilly) (Flat) (Level)

(4) Purpose of Well: municipal
(Domestic Irrigation
Municipal, Industrial, Other)

Information upon completion of well:

- (1) Diameter 12 inches.
- (2) Total Depth 935' feet.
- (3) Water Level 280' feet below top of ground.
- (4) Cased to 867' 8", Size 12"
- (5) Screen: Size 8", Length 60'
- (6) Were any formations sealed against pollution?
X yes, _____ no.


If YES depth of formation 867' 8"

Why Required

Drillers Remarks: _____

Description & Color of Materials Sand, Clay, Red Clay, Shell, etc.	Thick- ness Feet	Depth Feet
hard brittle clay	12	12
red sand-gravel	22	34
red clay-gummy	107	141
hard shale	70	211
shale-sand stks.	33	244
gummy shale	36	280
shale-sand strks	64	344
gummy shale	41	385
coarse sand	21	406
gummy shale	34	440
fine sand-shale stks	62	502
hard lime	14	516
gummy shale-sand bks	19	535
shale-fine sand breaks	65	600
gummy shale-sand brks	74	674
shale-fine sand	79	753
fine sand-shale stks	96	849
hard lime	11	860
sand-shale streaks	15	875
h.p. sand	58	933
hard lime	5	948

CODED

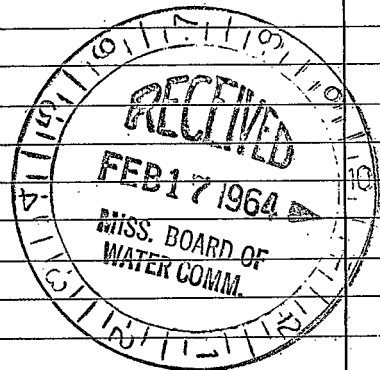

Well No.

(Use Back Side)

