

M7

11-7-62

WATER WELL DRILLERS LOG

CODED


Date: 11-7, 1962, Driller: Chester Reeves County Wilkinson
 (Name)

(1) Owner of Land: John McCrave
 (Name)
Woodville -
 (Address)
29 2N 2W
 (2) Location: 1/4, 1/4, Sec. T R
1 miles North of Woodville
 (distance) (direction) (Nearest Town)
Highway 61
 (3) Topography: Hilly
 (Hilly) (Flat) (Level)
 (4) Purpose of Well: Domestic
 (Domestic Irrigation Municipal, Industrial, Other)

Description & Color of Materials Sand, Clay, Red Clay, Shell, etc.	Thick- ness Feet	Depth Feet
<u>clay</u>	<u>12</u>	<u>12</u>
<u>sand & gravel</u>	<u>28</u>	<u>40</u>
<u>white clay</u>	<u>10</u>	<u>50</u>
<u>Brown sand</u>	<u>22</u>	<u>72</u>

Information upon completion of well:

(1) Diameter 4" inches.
 (2) Total Depth 72 feet.
 (3) Water Level 60 feet below top of ground.
 (4) Cased to Bottom Size 4"
 (5) Screen: Size 4", Length 4"
 (6) Were any formations sealed against pollution?
no.

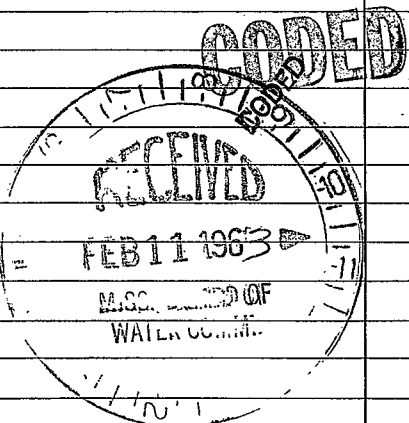

If YES depth of formation _____
 Why _____
 Drillers Remarks: old 2" well
sanded

REEVES WELL & PUMP CO.
 P. O. BOX 71 -- PHONE 684-1451
 McCOMB, MISS.

(Use Back Side)

Well No.

