

WILK.

**CUBED**

M8

2-5-62

**WATER WELL DRILLERS LOG**

Date: 2-5, 1962, Driller: Crestor Rennie Wilkinson County

(Name)

**CUBED**

(1) Owner of Land: S.E. McCraine  
 (Name)  
Rt. 3, Babalonng, La.  
 (Address)

(2) Location: 1/4, 1/4, Sec. 24 T 20 R 20  
1 miles North of Woodville  
 (distance) (direction) (Nearest Town)

(3) Topography: Hilly  
 (Hilly) (Flat) (Level)

(4) Purpose of Well: Domestic  
 (Domestic Irrigation  
 Municipal, Industrial, Other)

Description & Color of Materials Sand, Clay, Red Clay, Shell, etc.	Thick- ness Feet
<u>Brown Clay</u>	<u>20</u>
<u>Sand - (20-25)</u>	<u>5</u>
<u>White chert (25-30)</u>	<u>80</u>
<u>Fine white sand</u> <u>(105-120)</u>	<u>15</u>
<u>white sand</u> <u>(120-132)</u>	<u>12</u>

Information upon completion of well:

(1) Diameter 2 inches.

(2) Total Depth 132 feet.

(3) Water Level 95 feet below top of ground.

(4) Cased to Bottom, Size 2"

(5) Screen: Size 1/4, Length 6"


(6) Were any formations sealed against pollution?  
 \_\_\_\_\_ yes,  no.

**CUBED**

If YES depth of formation \_\_\_\_\_

Why \_\_\_\_\_

Drillers Remarks: old well  
went bad.

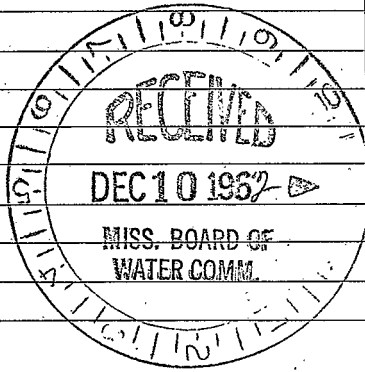

(Use Back Side).

