

Leslie
CODED

Wilkinson
M10
8-68

MISSISSIPPI
BOARD OF WATER COMMISSIONERS
416 North State Street
Jackson, Mississippi 39201

WATER WELL DRILLERS LOG

8-29-68 date well completed
Hiner Water Well Ser. Wilkinson firm name
county well located

LANDOWNER:
Jim Wilkinson
Woodville, Miss
(mailing address)

description of formations encountered	from	to
Top soil	0	3
Chalk	3	30
Sand	30	130
Shale	130	331
Sand	311	331

WELL LOCATION:
sec. 12 T 20 N R 2 E
S. (W)
3/2 miles N of Woodville
(distance) (direction) (nearest town)


WELL PURPOSE: Home
(home, irrigation, municipal, industrial)

WELL COMPLETION DATA:

- (1) diameter (inches) 2"
- (2) total depth (feet) 331
- (3) static water level (feet) 210 ^{below}/_{above} top of ground.
- (4) casing Galv. 319'
(material) (depth)
2" if telescope see back.
(size)
- (5) screen 10', 319'
(length) (depth to top)
2", 55.
(size) (material)
- (6) pump 2 10
(HP) (yield gpm)
electric
(type power)
- (7) electric log no.
(yes or no)


(organization running log)
- (8) how well bottom plugged Wood Plug

DRILLERS REMARKS:

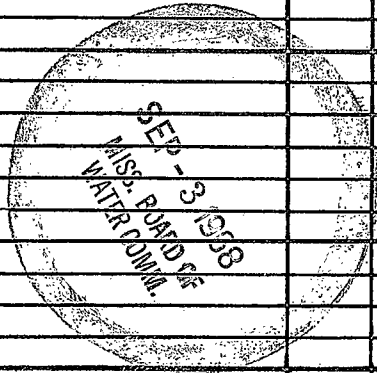

If well telescopes please sketch and show depths.

GROUND LEVEL

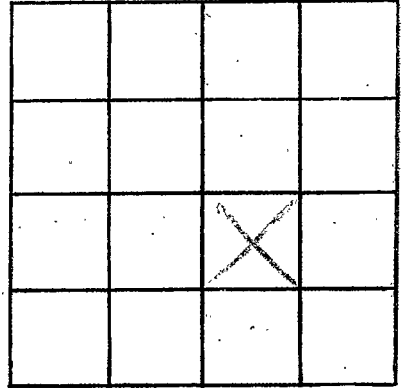

SECTION 12

Please indicate well location X.

ADDITIONAL INFORMATION

If more than one screen, show locations of each on sketch.