

**WILKINSON**  
**MI**  
**11-22-73**

MISSISSIPPI  
 BOARD OF WATER COMMISSIONERS  
 416 North State Street  
 Jackson, Mississippi 39201

**CODED**

**WATER WELL DRILLERS LOG**

11-22 1973 Armer Water Well In Wilkinson  
 date well completed firm name county well located


LANDOWNER:	description of formations encountered	from	to
<u>Burt Stearns</u>			
<u>Woodville, Miss.</u> (mailing address)	<u>red clay</u>	<u>2</u>	<u>6</u>
WELL LOCATION: sec. <u>12</u> T. <u>2</u> S. R. <u>2</u> E. (NW)	<u>grey clay</u>	<u>6</u>	<u>136</u>
<u>5</u> miles <u>SW</u> of <u>Woodville</u> (distance) (direction) (nearest town)	<u>Coarse sand</u>	<u>136</u>	<u>125</u>
WELL PURPOSE: <u>Home</u> (home, irrigation, municipal, industrial)			
WELL COMPLETION DATA:			
(1) diameter (inches) <u>2"</u>			
(2) total depth (feet) <u>125'</u>			
(3) static water level (feet) <u>78'</u> below top of ground.			
(4) casing <u>Galv.</u> <u>108'</u> (material) (depth)			
<u>2"</u> (size) If telescope see back.			
(5) screen <u>5'</u> <u>108'</u> (length) (depth to top)			
<u>2"</u> <u>"55"</u> (size) (material)			
(6) pump <u>1</u> <u>50 gpm</u> (HP) (yield gpm)			
<u>elec.</u> (type power)			
(7) electric log <u>no</u> (yes or no)			
(organization running log)			
(8) how well bottom plugged <u>Woodville</u>			
DRILLERS REMARKS:			

**CODED**

ALCO RD. OF WATER CO. INC.

If well telescopes please sketch and show depths.

GROUND LEVEL

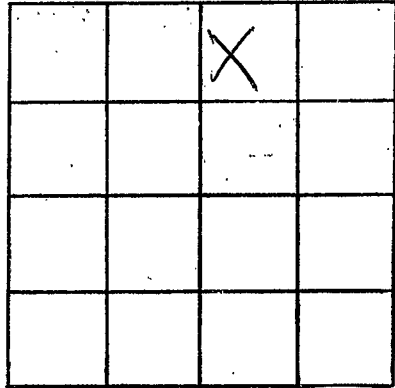

SECTION 17

Please indicate well location X.

ADDITIONAL INFORMATION

If more than one screen, show locations of each on sketch.